


PLAT OF SURVEY

FO-

LOT 3 OF CERTIFIED SURVEY MAP NO. 2907 AS RECORDED IN VOLUME 10 OF CERTIFIED SURVEY MAPS ON PAGE 81 IN THE WALWORTH COUNTY REGISTER OF DEEDS, BEING LOCATED IN PART OF THE SOUTHWEST 1/4 OF THE NORTHWEST 1/4 OF SECTION 15, TOWNSHIP 1 NORTH, RANGE 16 EAST OF THE FOURTH PRINCIPAL MERIDIAN, IN THE TOWN OF WALWORTH, WALWORTH COUNTY, WISCONSIN.

SURVEY FOR: KAREN HEYER

SURVEY LOCATION: W6074 BRICK CHURCH ROAD

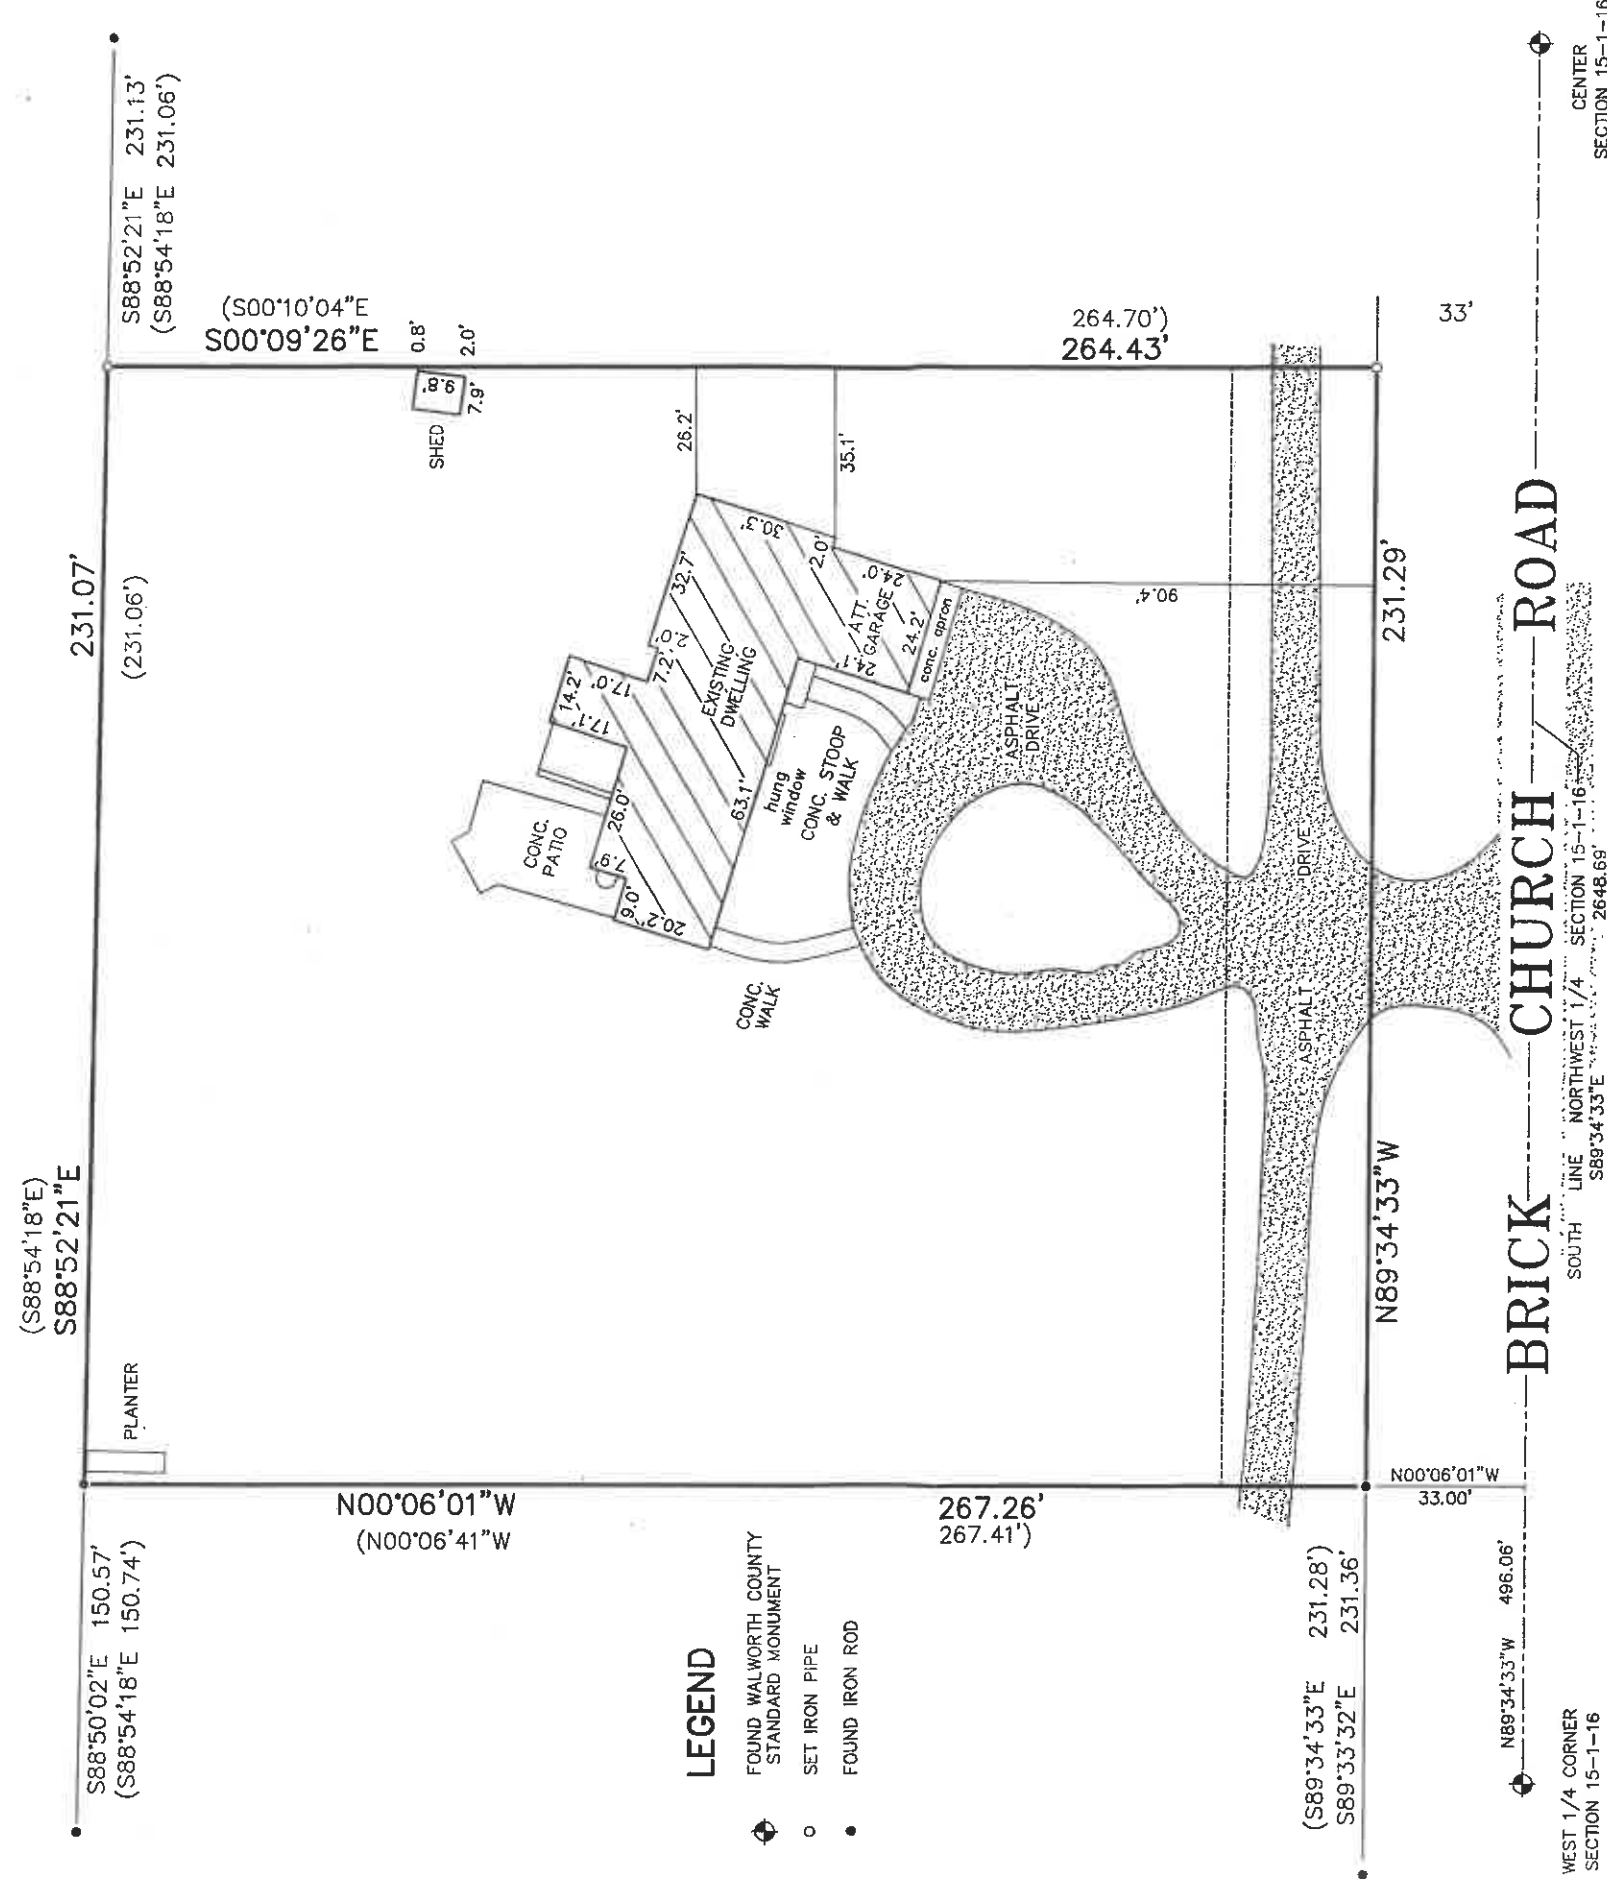

REFER TO A CURRENT TITLE REPORT FOR EASEMENTS OR RESTRICTIONS WHICH MAY AFFECT THIS USE OF THIS SITE.

"I hereby certify that I have surveyed the above described property and that the above map is a correct representation thereof and shows the size and location of the property, its exterior boundaries, the location of all visible structures and dimensions of all principal buildings thereon, boundary fences, apparent easements, roadways and encroachments, if any."

"This survey is made for the use of the present owners of the property, and those who purchase, mortgage, or guarantee the title thereto within one year from date hereof."



THIS IS NOT AN ORIGINAL PRINT
UNLESS THIS SEAL IS RED.

B.W. SURVEYING, INC.

LAND SURVEYS
MAPPING AND PLANNING
412 N. PINE STREET
BURLINGTON, WI 53105
(262)-767-0225



GRAPHIC SCALE



Robert J. Wetzel S-778

JUNE 8, 2021
DATE

10405
JOB NUMBER