
## DUNHAM SURVEYING, S.C.

SURVEYING & SUBDIVIDING DELAVAN, WISCONSIN 53115

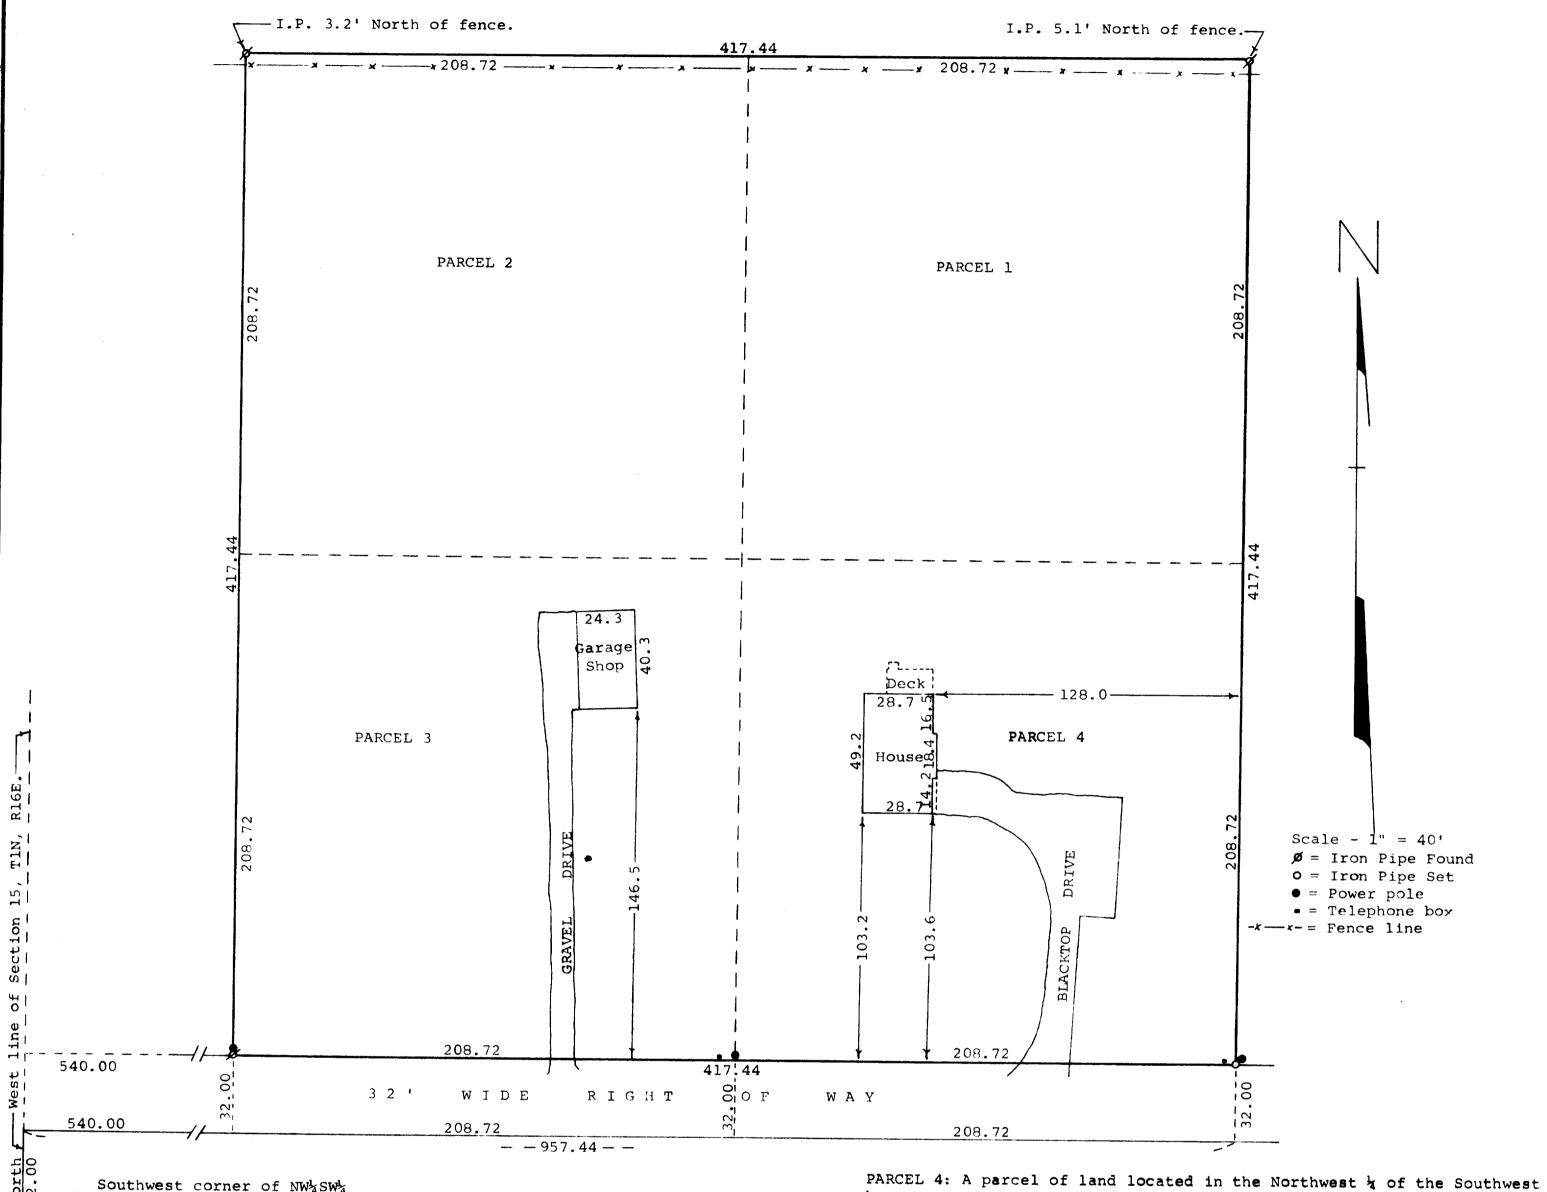

Southwest corner of NW4SW4 of Section 15-1-16.

STATE OF WISCONSIN) COUNTY OF WALWORTH) SS

I, James M. Dunham, Surveyor, certify that I have surveyed the property described as follows,

PARCEL 1: A parcel of land located in the Northwest & of the Southwest of Section 15, TlN, R16E, Walworth County, Wisconsin, described as follows: Commencing at the Southwest corner of said NW4; thence North along the west line of said section 242.00 feet to a point; thence East parallel to the south line of said NW4, 748.72 feet to an iron pipe; thence North parallel with the west line of said section 240.72 feet to the place of beginning; thence continue North parallel with the west line of said section 208.72 feet; thence East parallel with the south line of said NW 208.72 feet; thence South parallel with the west line of said section 208.72 feet; thence West parallel with the south line of said NW 208.72 feet to the place of beginning. PARCEL 2: A parcel of land located in the Northwest 4 of the Southwest 4 of Section 15, TlN, R16E, Walworth County, Wisconsin, described as follows: Commencing at the Southwest corner of said NW4; thence North along the west line of said section 242.00 feet to a point; thence East parallel with the south line of said NW 540.00 feet to an iron pipe; thence North parallel with the west line of said section 240.72 feet to the place of beginning; thence continue North parallel with the west line of said section 208.72 feet; thence East parallel with the south line of said NW 208.72 feet; thence South parallel with the west line of said section 208.72 feet; thence West parallel with the south line of said NW 208.72 feet to the place of beginning. PARCEL 3: A parcel of land located in the Northwest & of the Southwest  $\frac{1}{4}$  of Section 15, TlN, R16E, Walworth County, Wisconsin, described as follows: Commencing at the Southwest corner of said Northwest 4; thence North along the west line of said section 242.00 feet to a point; thence East parallel with the south line of said NW 540.00 feet to an iron pipe; thence North parallel to the west line of said section 32.00 feet to an iron pipe and the place of beginning; thence continue North parallel to the west line of said section 208.72 feet to an iron pipe; thence East parallel to the south line of said NW 208.72 feet to an iron pipe; thence South parallel to the west line of said section 208.72 feet to an iron pipe; thence West parallel to the south line of said NW 208.72 feet to the place of beginning.

of Section 15, TlN, R16E, Walworth County, Wisconsin, described as follows: Commencing at the Southwest corner of said Northwest 1; thence North along the west line of said section 242.00 feet to a point; thence East parallel to the south line of said NW 957.44 feet to an iron pipe; thence North parallel to the west line of said section 32.00 feet to an iron pipe and the place of beginning; thence continue North parallel to the west line of said section 208.72 feet to an iron pipe; thence West parallel to the south line of said NW 208.72 feet to an iron pipe; thence South parallel to the west line of said section 208.72 feet to an iron pipe; thence East parallel to the south line of said NW 208.72 feet to the place of beginning.


PARCEL 5: Also a right of way, in common with others, over and along a strip of land 32.00 feet in width described as follows: Beginning at the Southeast corner of the above described PARCEL 4; thence West parallel to the south line of said Northwest & 957.44 feet to the west line of said section; thence South along said west line 32.00 feet to a point; thence East parallel to the south line of said Northwest 1/2 957.44 feet to an iron pipe; thence North 32.00 feet to the place of beginning.

and the above map is a true representation thereof and shows the size and location of the property, its exterior boundaries, the location and dimensions of all structures thereon, fences, apparent easements and roadways and visible encroachments, if any.

This survey is made for the exclusive use of the present owners of the property, and also those who purchase, mortgage, or guarantee the title thereto within one (1) year from date hereof; and as to them I warrant the accuracy of said survey and map.

February 21, 1977

James M. Dunham, Surveyor

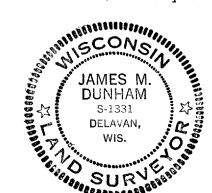

W-15-15

K & E 10 9155 250 9 76