


JENSEN SURVEYING & MAPPING S.C.
P.O. BOX 322
ELKHORN, WI. 53121

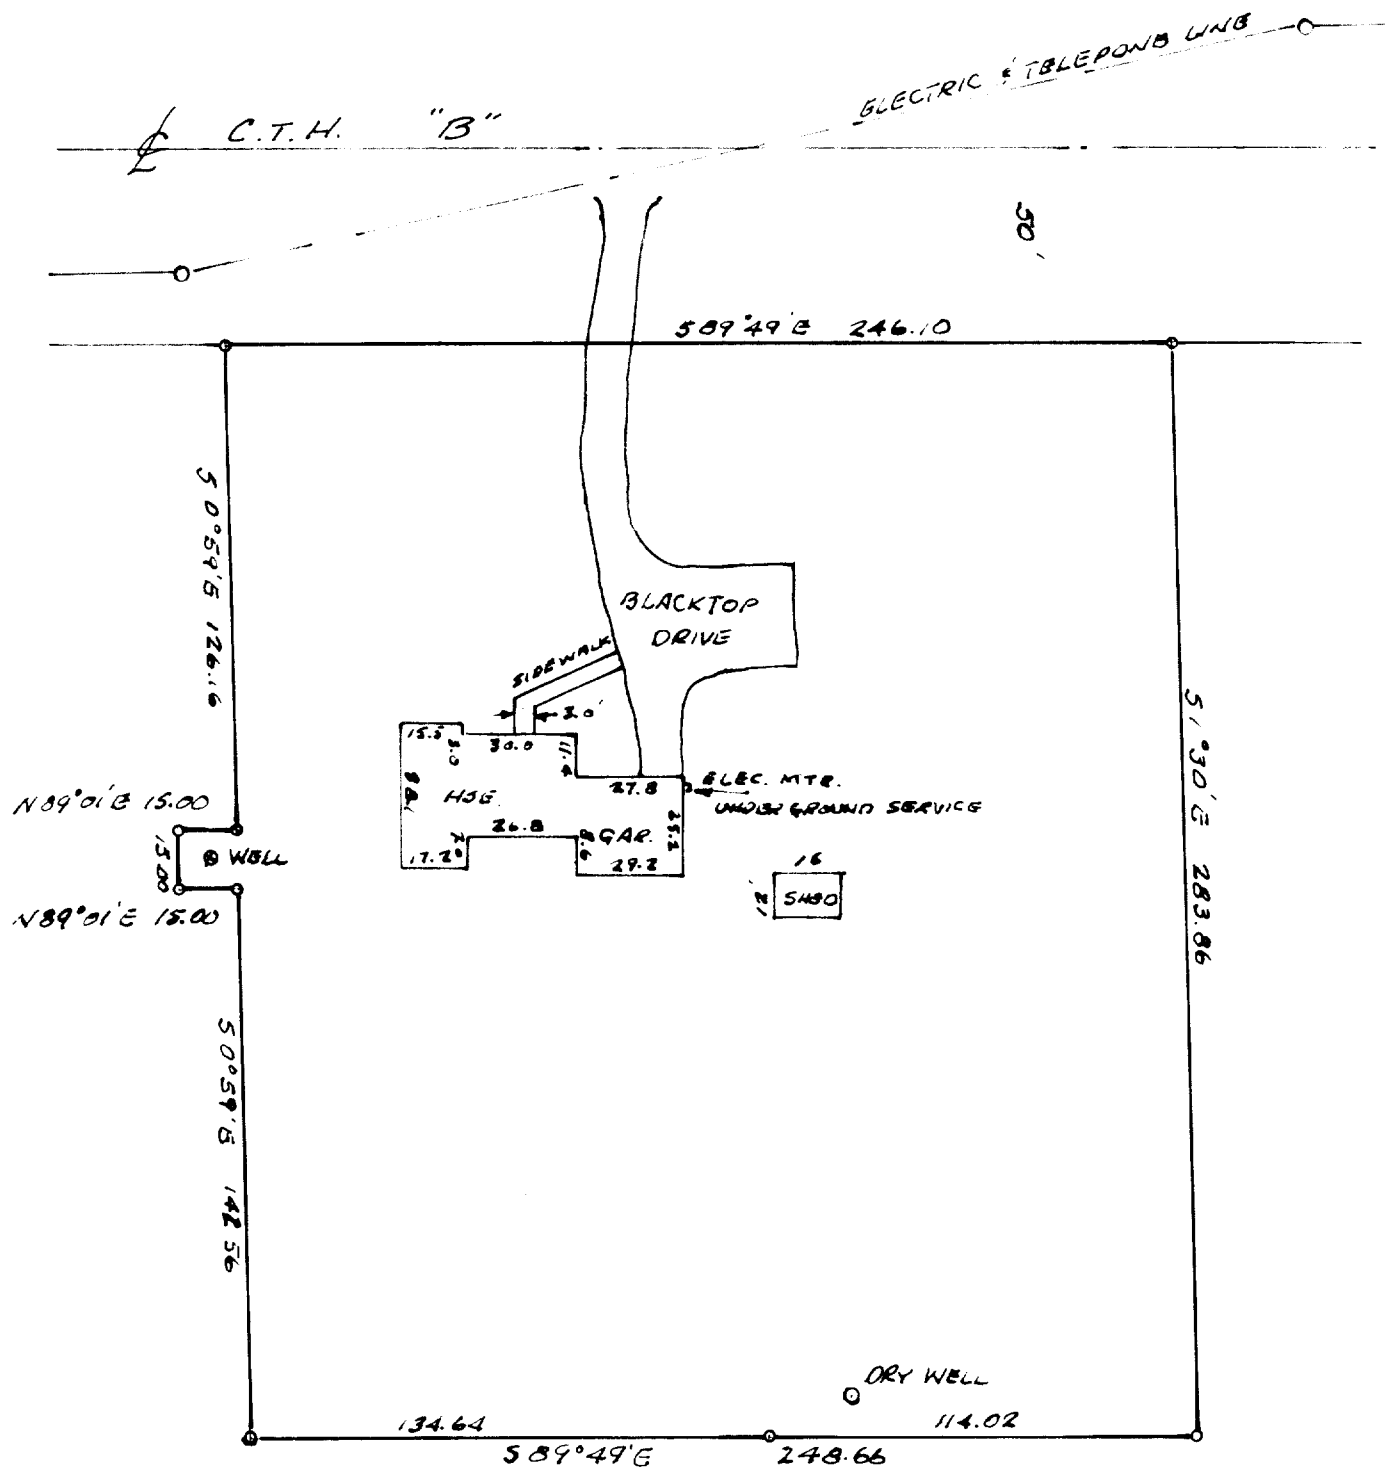

PLAT OF SURVEY OF

CERTIFIED SURVEY NO. 554, LOCATED IN THE
S.E. 1/4 OF SECTION 23, T1N, R16E,
WALWORTH COUNTY, WISCONSIN.

N



SCALE - 1" = 50'

○ - IRON PIPE FOUND

SURVEYED FOR: RAULAND AGENCY
WALWORTH, WI.

I HEREBY CERTIFY THAT I HAVE SURVEYED THE ABOVE
DESCRIBED PROPERTY, THAT THE PLAT SHOWN HEREON IS
AN ACCURATE SURVEY, A TRUE REPRESENTATION THEREOF,
CORRECTLY SHOWS THE EXTERIOR BOUNDARY LINES ON SAID
PROPERTY AND THE CORRECT MEASUREMENTS THEREOF
AND ALL BUILDINGS THEREON.

Thomas P. Jensen

THOMAS P. JENSEN, RLS 1084

DATE: JULY 28, 1983

C.S.M. 554

116-175-J

1983.040