
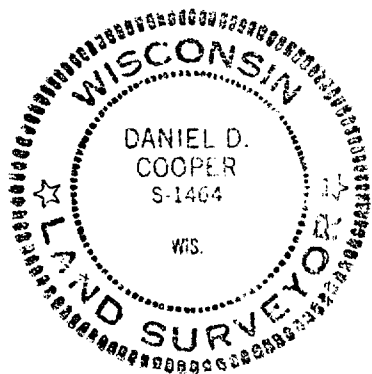
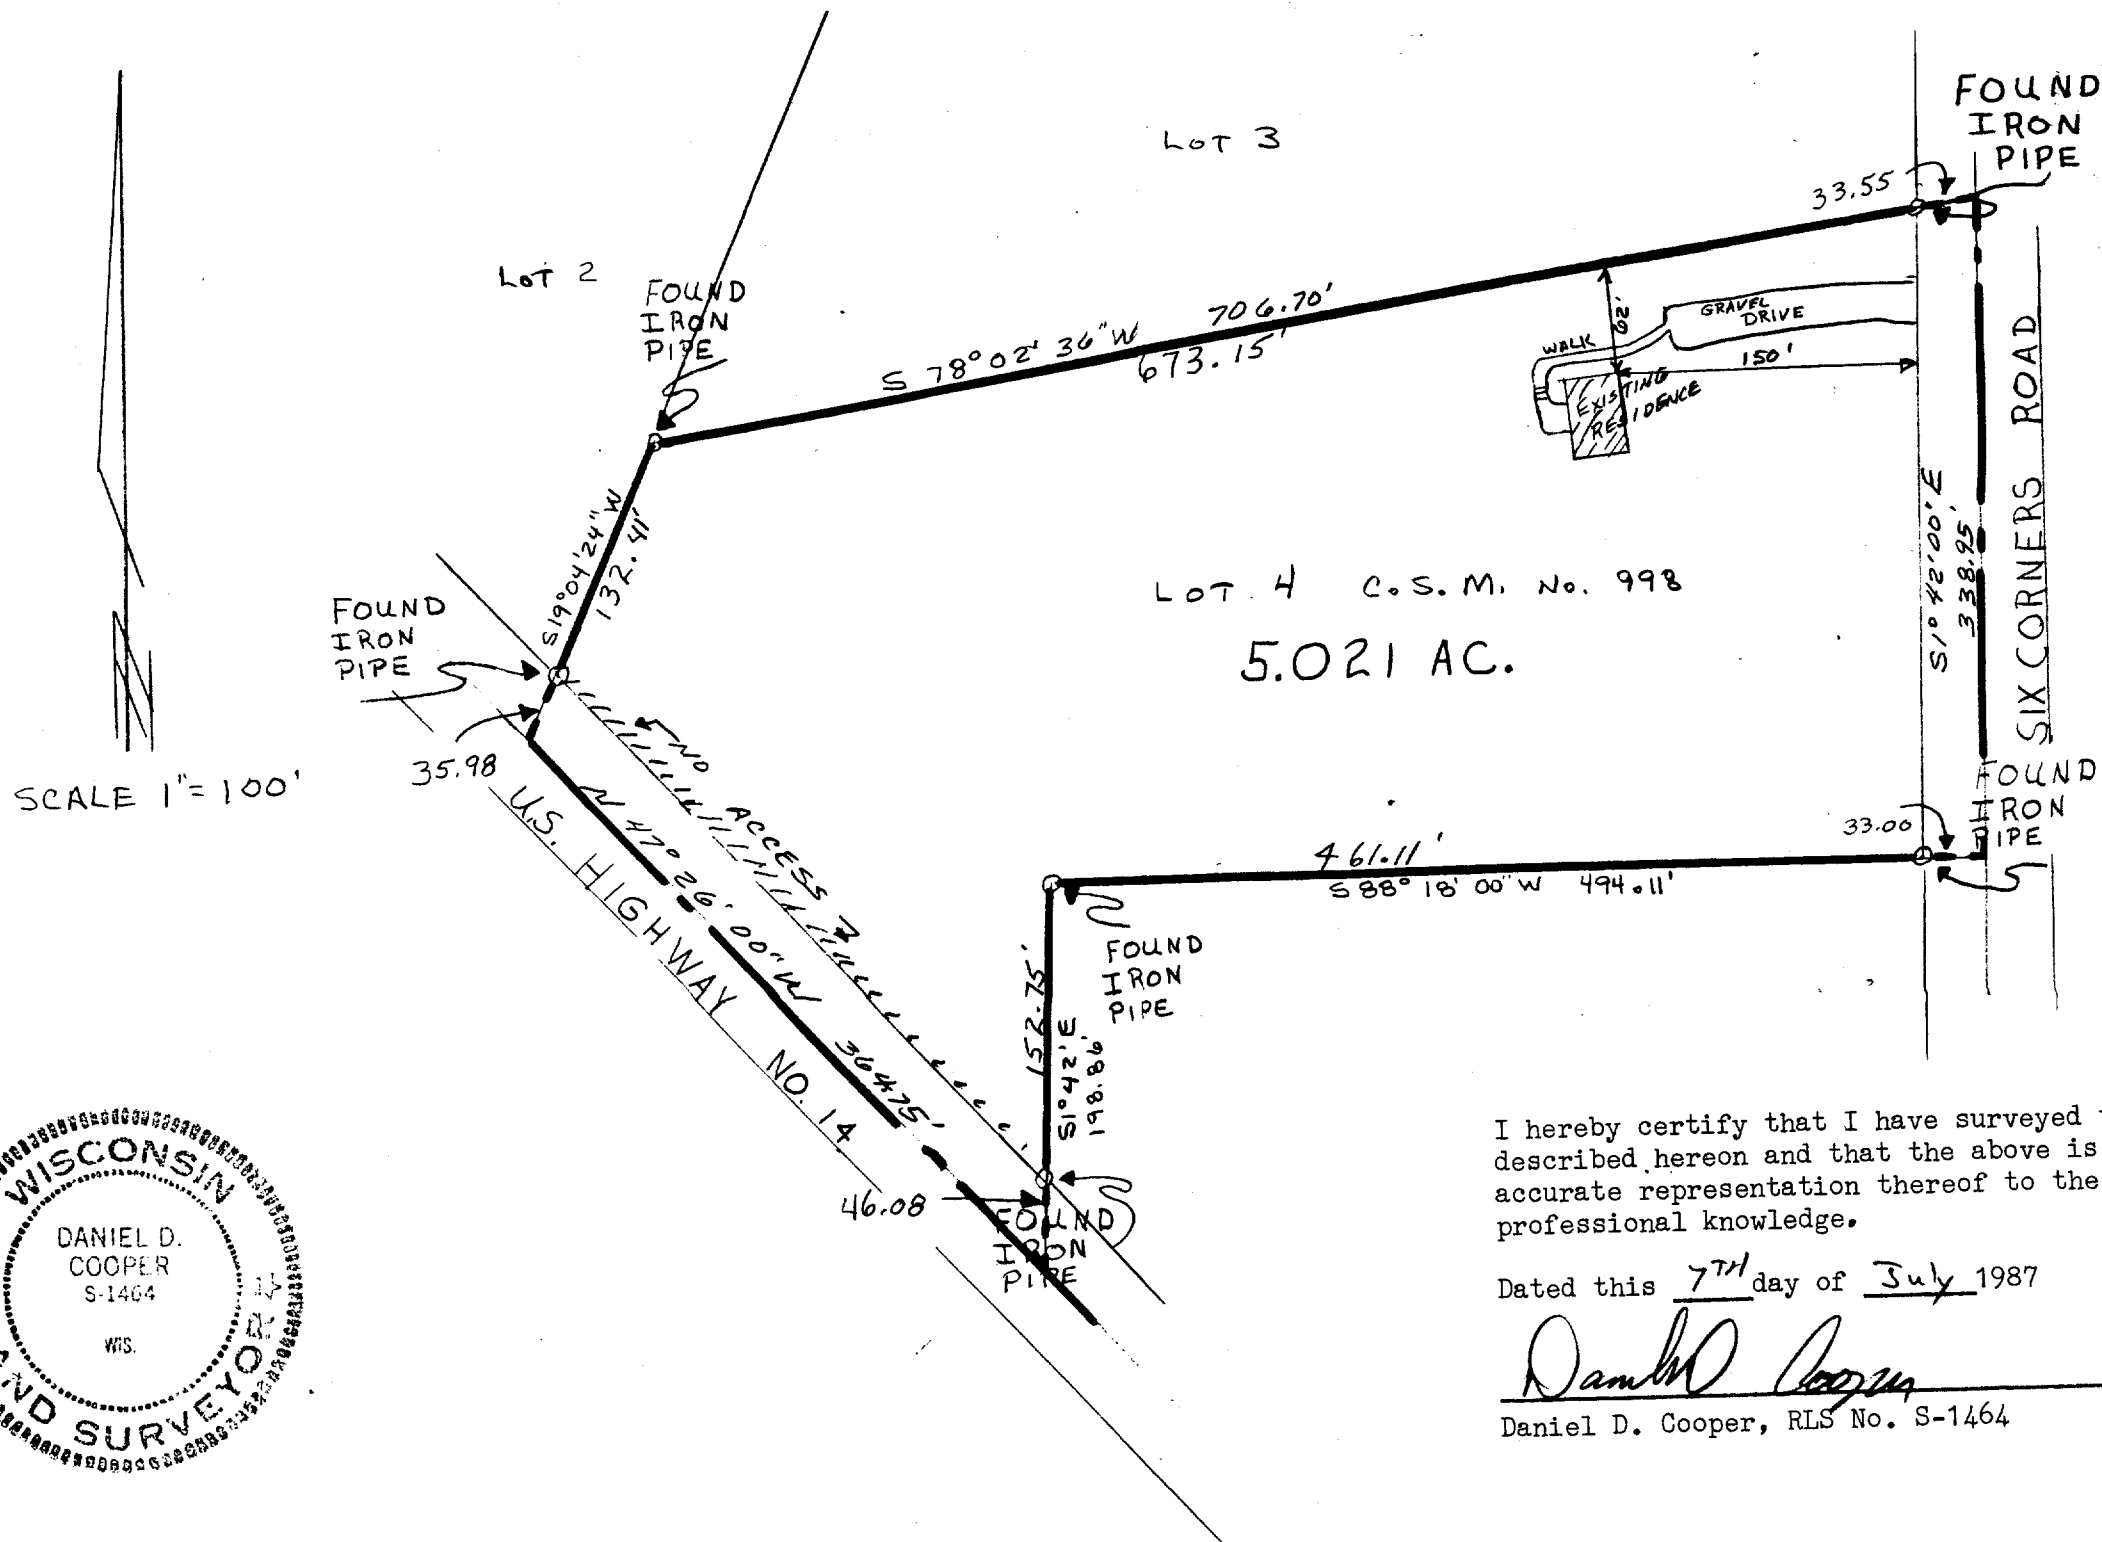


D. D. COOPER & CO., INC.
Daniel D. Cooper
P.O. Box 508B
Elkhorn, WI 53121

Plat of Survey of Lot No. 4 of Certified Survey Map No. 998.
Surveyed for John Birdsall.

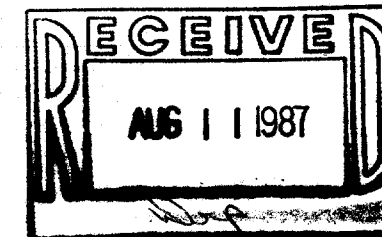

I hereby certify that I have surveyed the property described hereon and that the above is a true and accurate representation thereof to the best of my professional knowledge.

Dated this 7TH day of July 1987

Daniel D. Cooper

Daniel D. Cooper, RLS No. S-1464