



DUNHAM SURVEYING, S.C.
SURVEYING & SUBDIVIDING
DELAVAN, WISCONSIN 53115

N

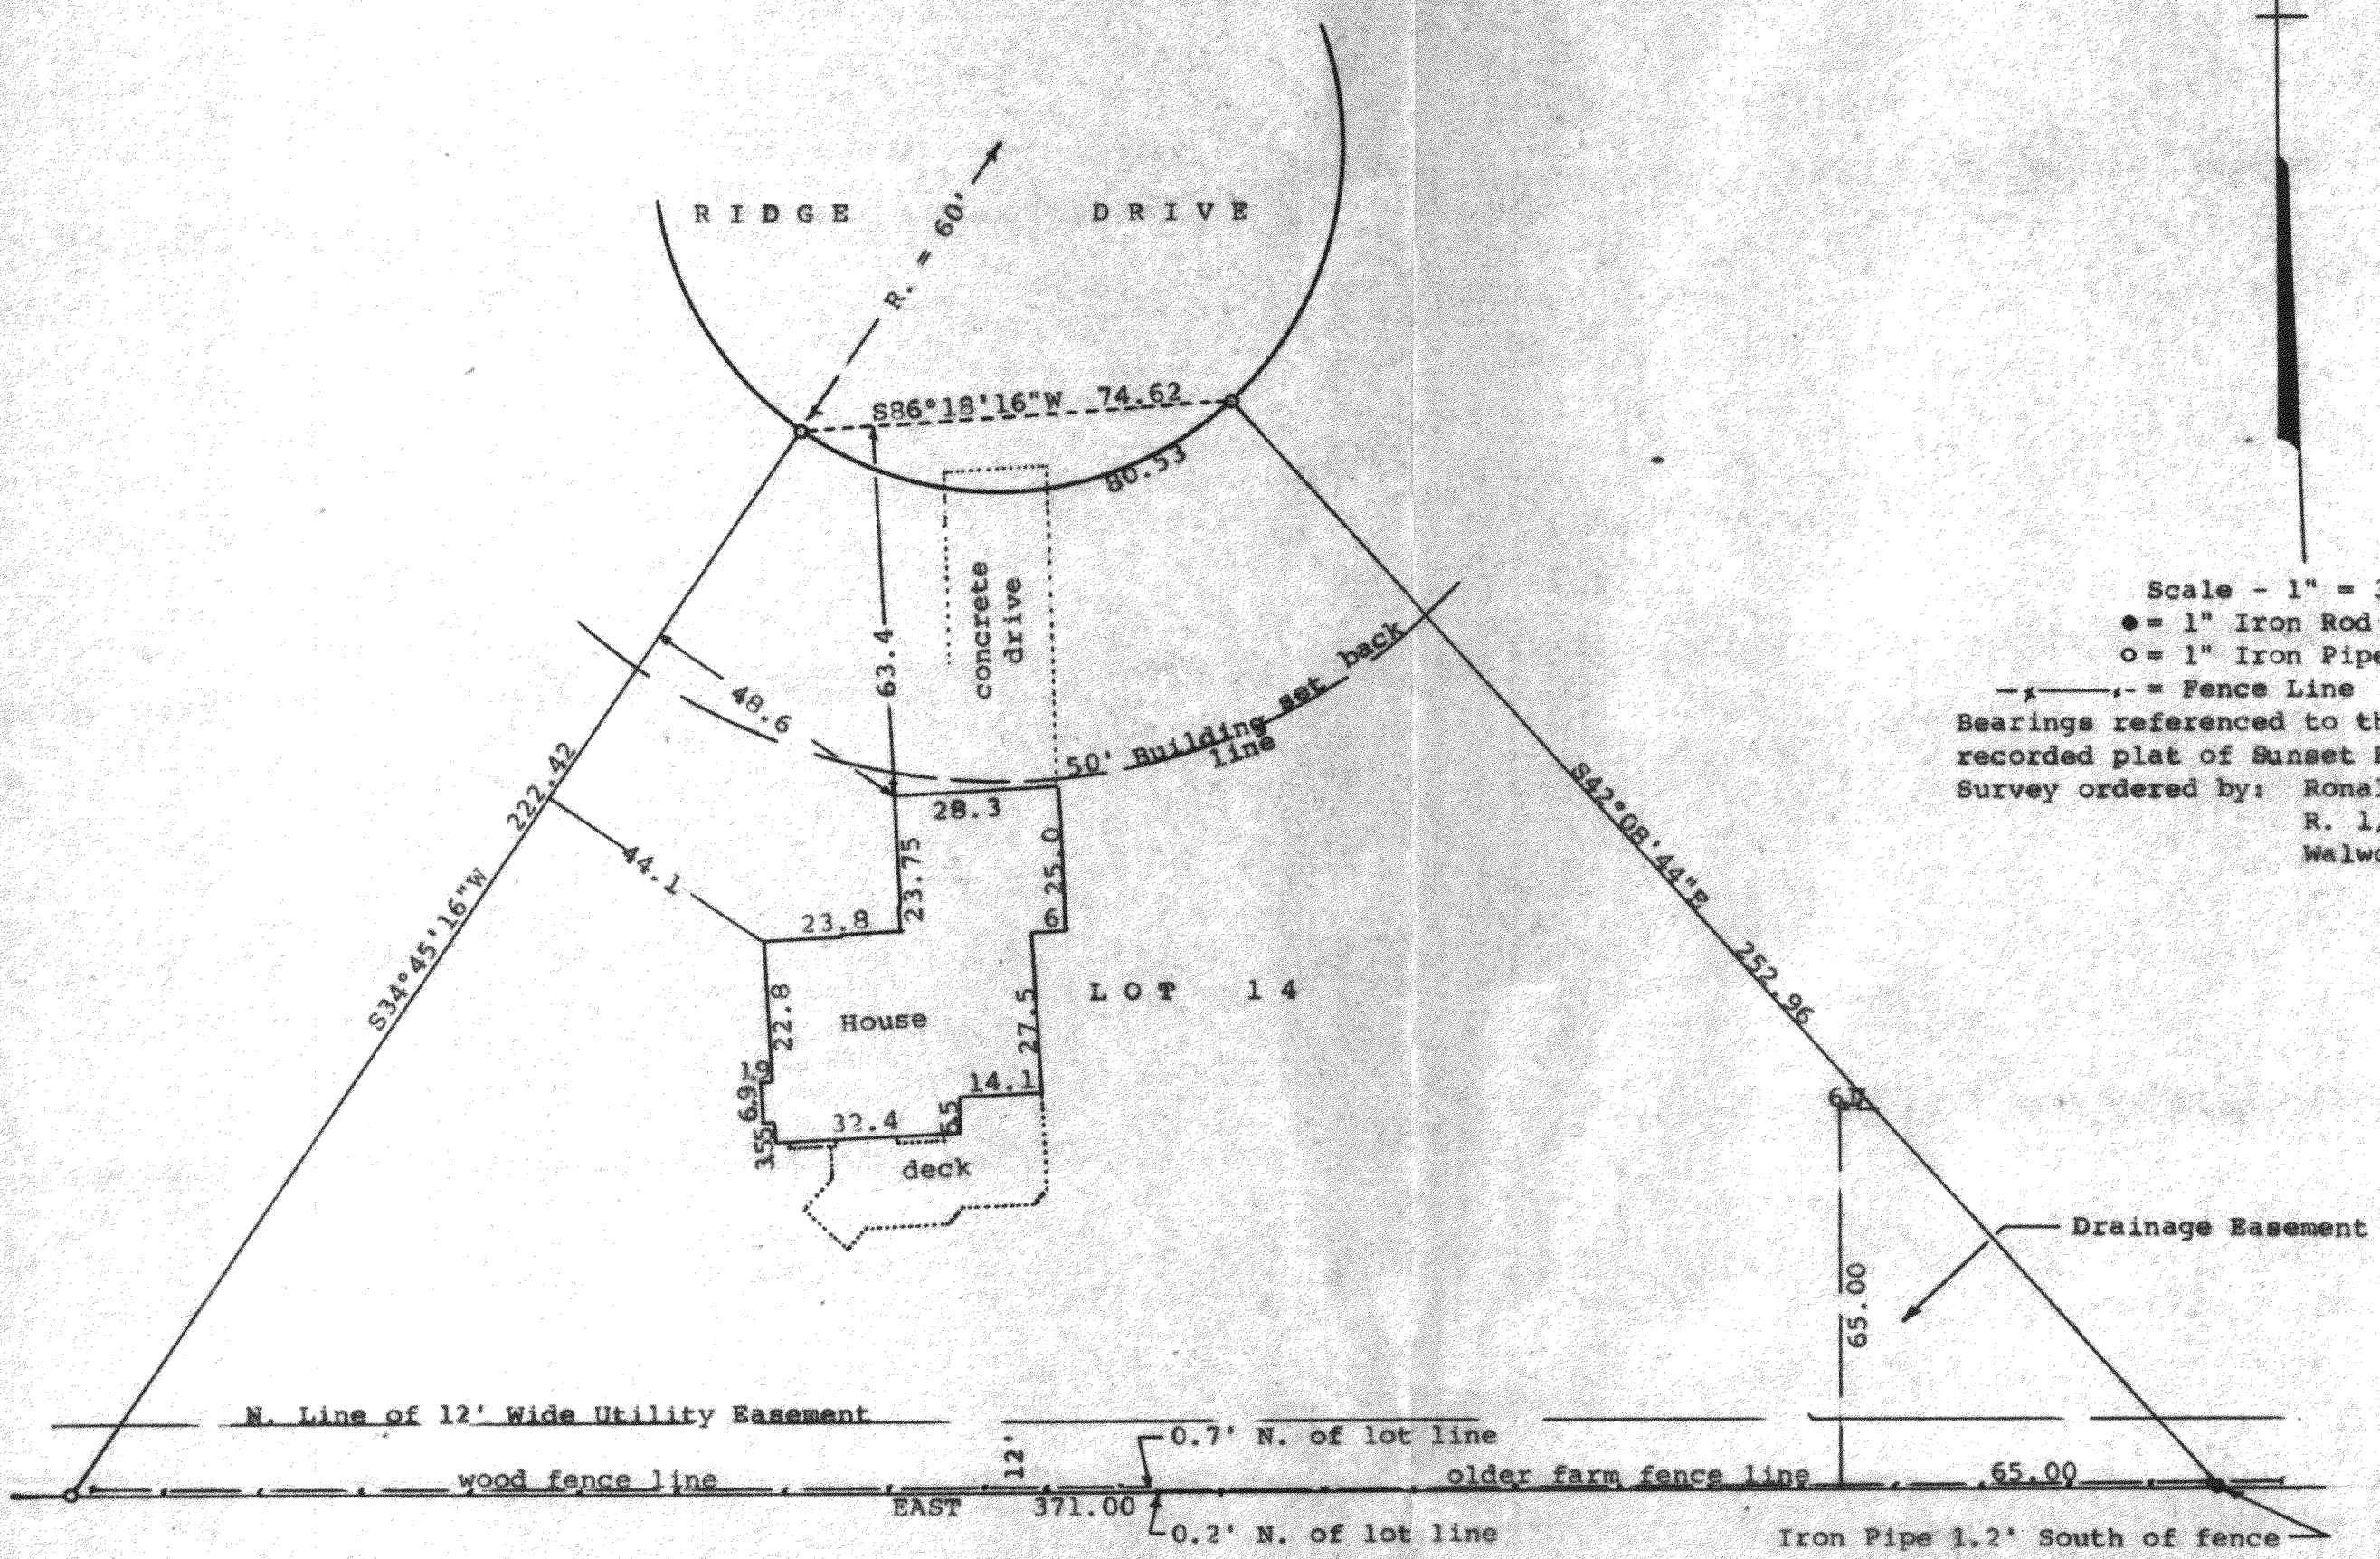

Scale - 1" = 30'
● = 1" Iron Rod Found
○ = 1" Iron Pipe Found
--- = Fence Line
Bearings referenced to those shown of the
recorded plat of Sunset Ridge - Unit 2
Survey ordered by: Ronald Nyman
R. 1, Box 295
Walworth, WI 53184

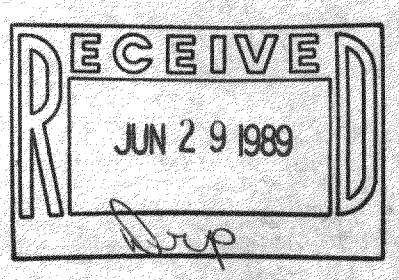

STATE OF WISCONSIN) SS
COUNTY OF WALWORTH)
I, George T. Dunham, Surveyor, certify that I have surveyed the property
described as follows:
Lot 14 in Sunset Ridge - Unit 2, located in the NW $\frac{1}{4}$ of the NW $\frac{1}{4}$ of Section
11, T 1 N, R 16 E, Walworth County, Wisconsin
and that the plat shown above is a correct representation thereof and shows
the size and location of the property, its exterior boundaries, the location
of all visible structures and dimensions of all principal buildings thereon,
boundary fences, apparent easements, roadways and visible encroachments, if
any, and that I have surveyed the property hereon described, according to the
official records, to the best of my knowledge and belief.
November 9, 1988

116-264

George T. Dunham
George T. Dunham, Surveyor

