

Farris, Hansen & Associates, Inc.

7 RIDGEWAY COURT, P.O. BOX 437, ELKHORN, WISCONSIN

TEL. 414-723-2098

LOCATION: CSM # 865

IN SW 1/4 SEC 29-1-16

WALWORTH CO., WI



10 0 10 20 30 40 50 60 70 80 90 100

MAP SCALE IN FEET

MAP LEGEND

- IRON PIPE STAKE FOUND
- IRON PIPE STAKE SET
- IRON ROD STAKE FOUND
- IRON ROD STAKE SET
- ★ CONCRETE MONUMENT FOUND
- (XXXXX) RECORD DIMENSION

PLAT OF SURVEY OF LOT 1 OF CERTIFIED SURVEY MAP NO. 865 RECORDED IN VOLUME 4 OF WALWORTH COUNTY CERTIFIED SURVEY MAPS ON PAGE 64 AS DOCUMENT NO. 39949

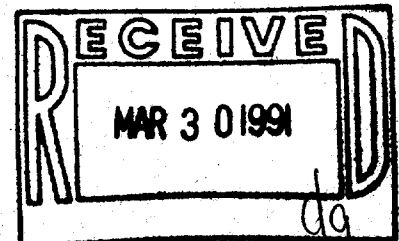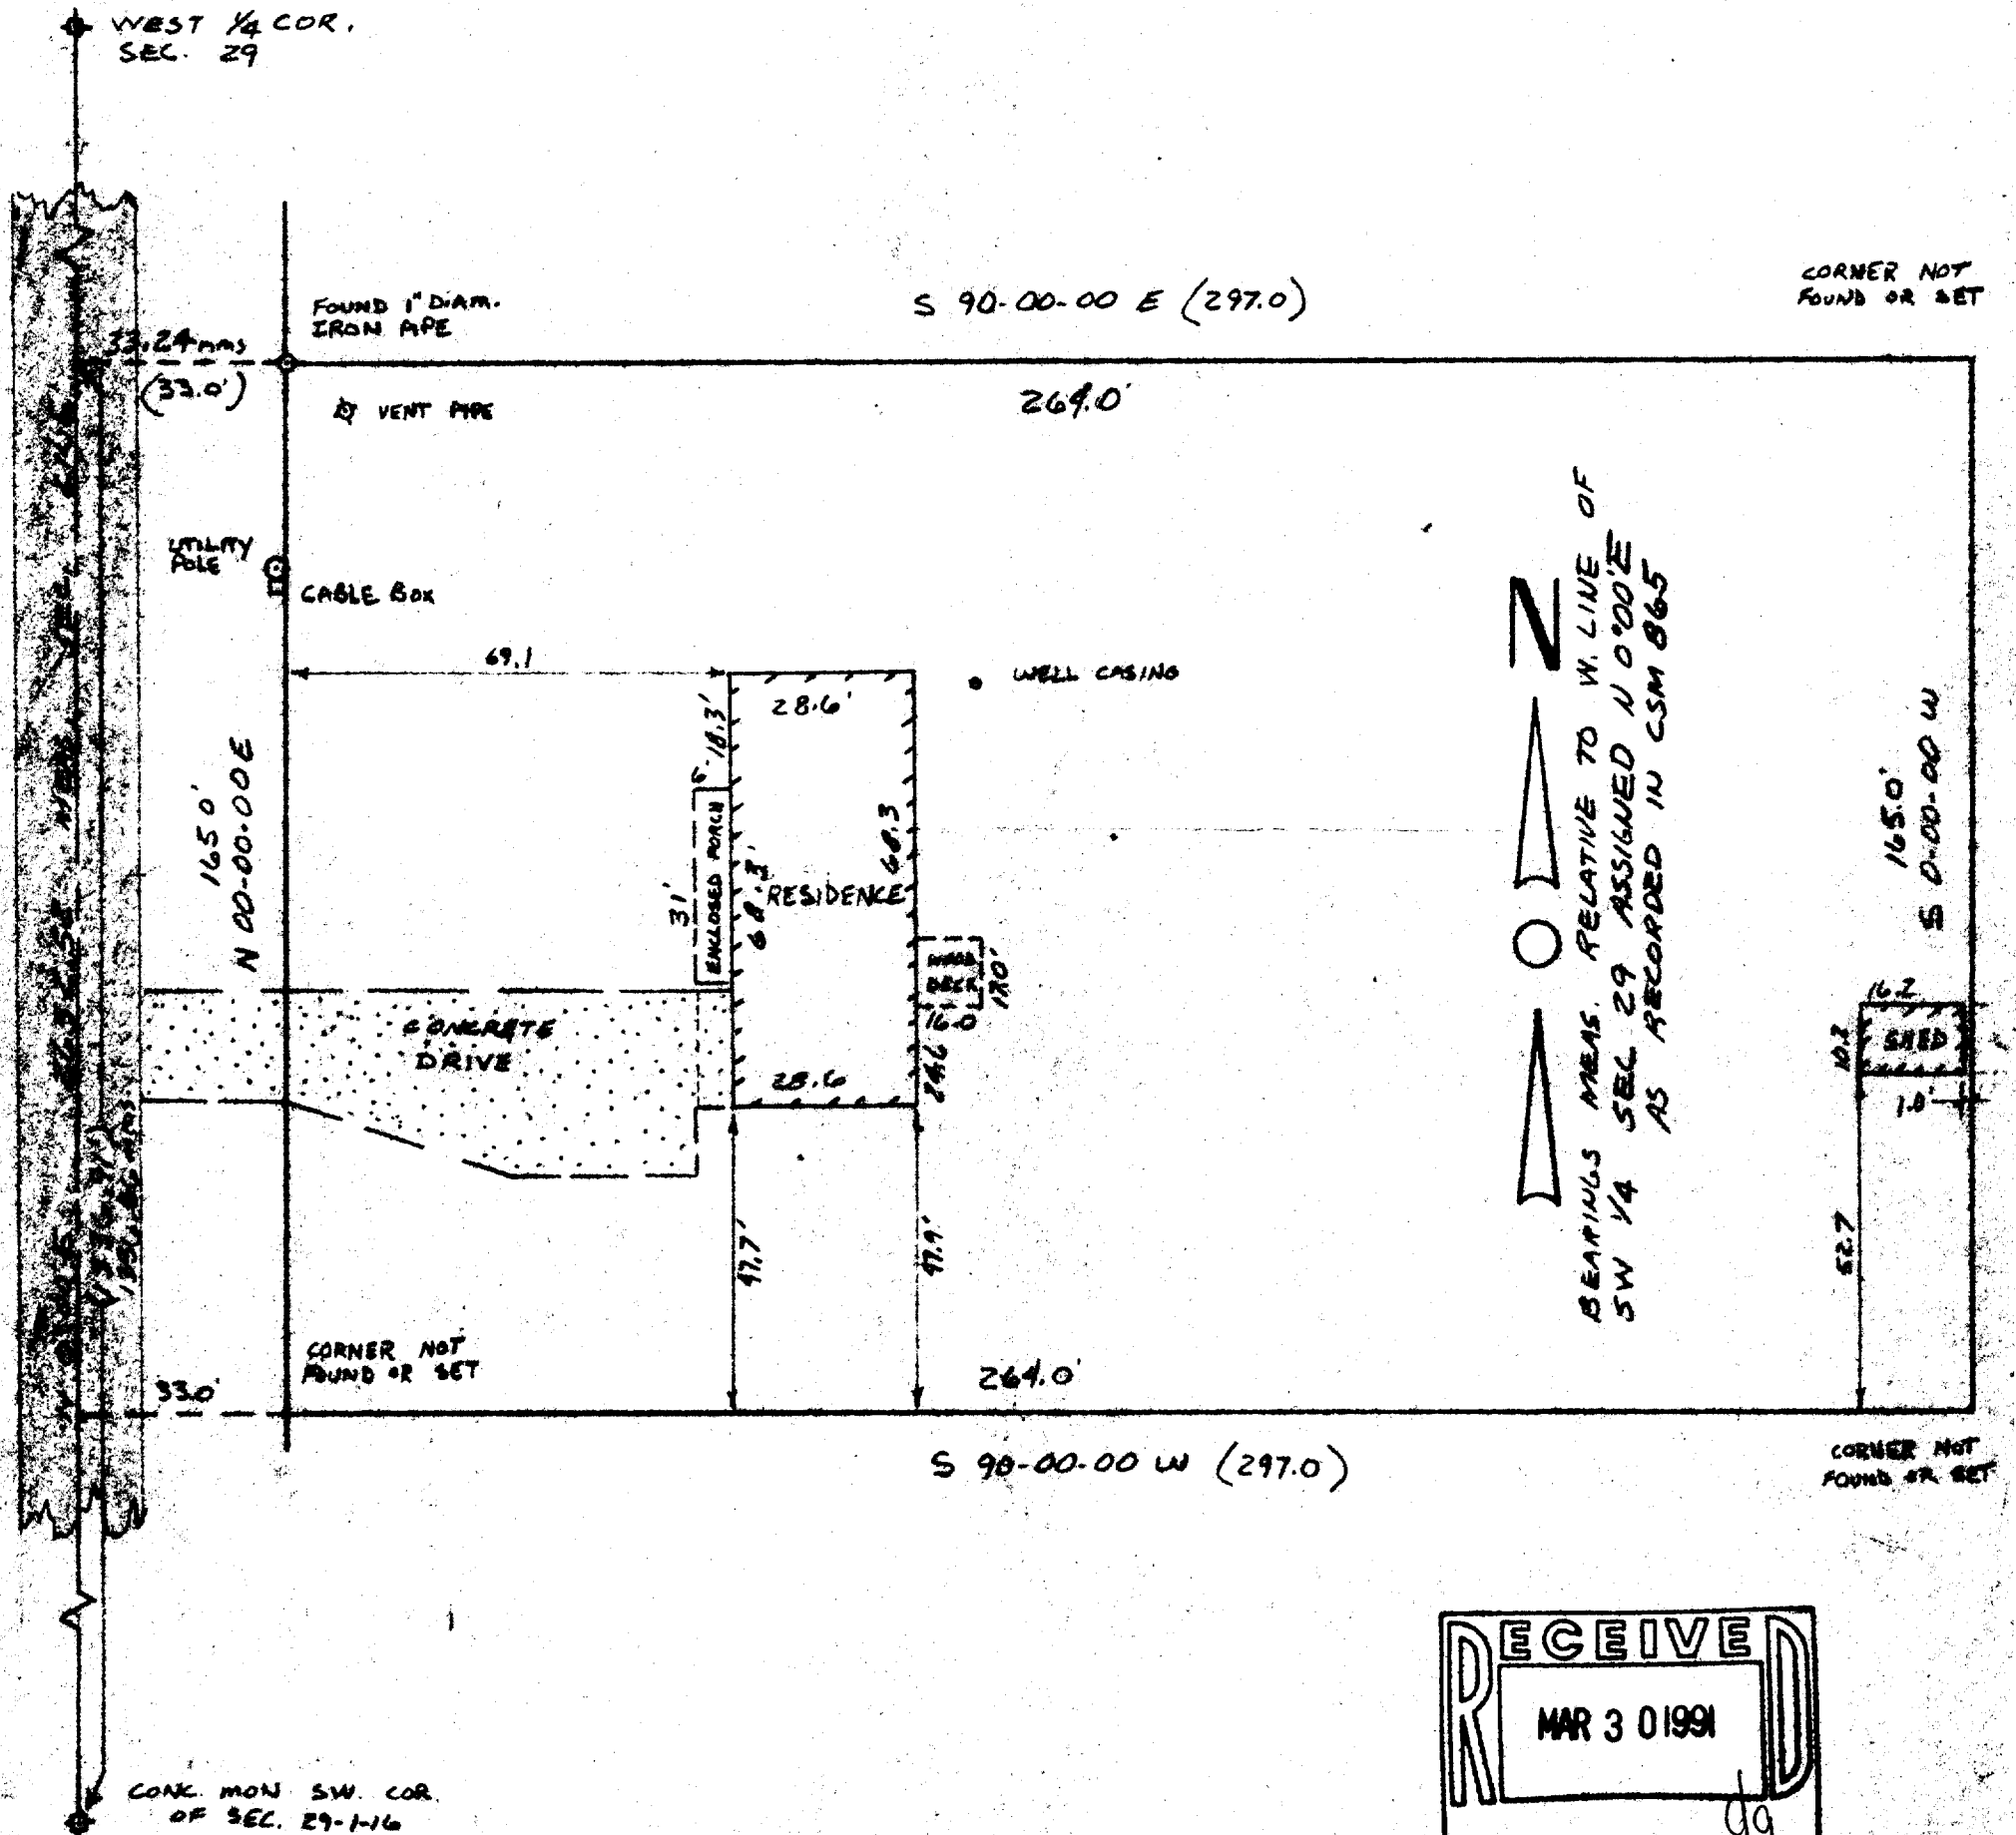

NOTE: COPIES OF THIS MAP TO WHICH THE FOLLOWING CERTIFICATE WILL APPLY ARE BLUE LINE PRINTS SHOWING SURVEYOR'S SEAL AND SIGNATURE IN BLACK INK. COPIES BY ANY OTHER MEANS MAY HAVE ALTERATIONS WHICH DO NOT REPRESENT THE SURVEYOR'S WORK PRODUCT.

I HEREBY CERTIFY THAT AT THE DIRECTION OF LEONARD CHRISTENSON THE ABOVE DESCRIBED LOT HAS BEEN SURVEYED FOR THE PURPOSE OF LOCATING ALL OF THE BUILDINGS AND OTHER VISIBLE IMPROVEMENTS EXISTING ON THE DATE HEREOF AND THAT THIS MAP IS A TRUE AND ACCURATE REPRESENTATION THEREOF TO THE BEST OF MY PROFESSIONAL KNOWLEDGE AND BELIEF.

DATED: SEPT. 6, 1990

Robert A. Farris



PROJ. NO. 3375

116-299

EA 8650001