


MAR 12 1992

N 1/4 CORNER SECTION 11-1-16

933.57'

OAK BLUFF ROAD 60' WIDE (PRIVATE ROAD)

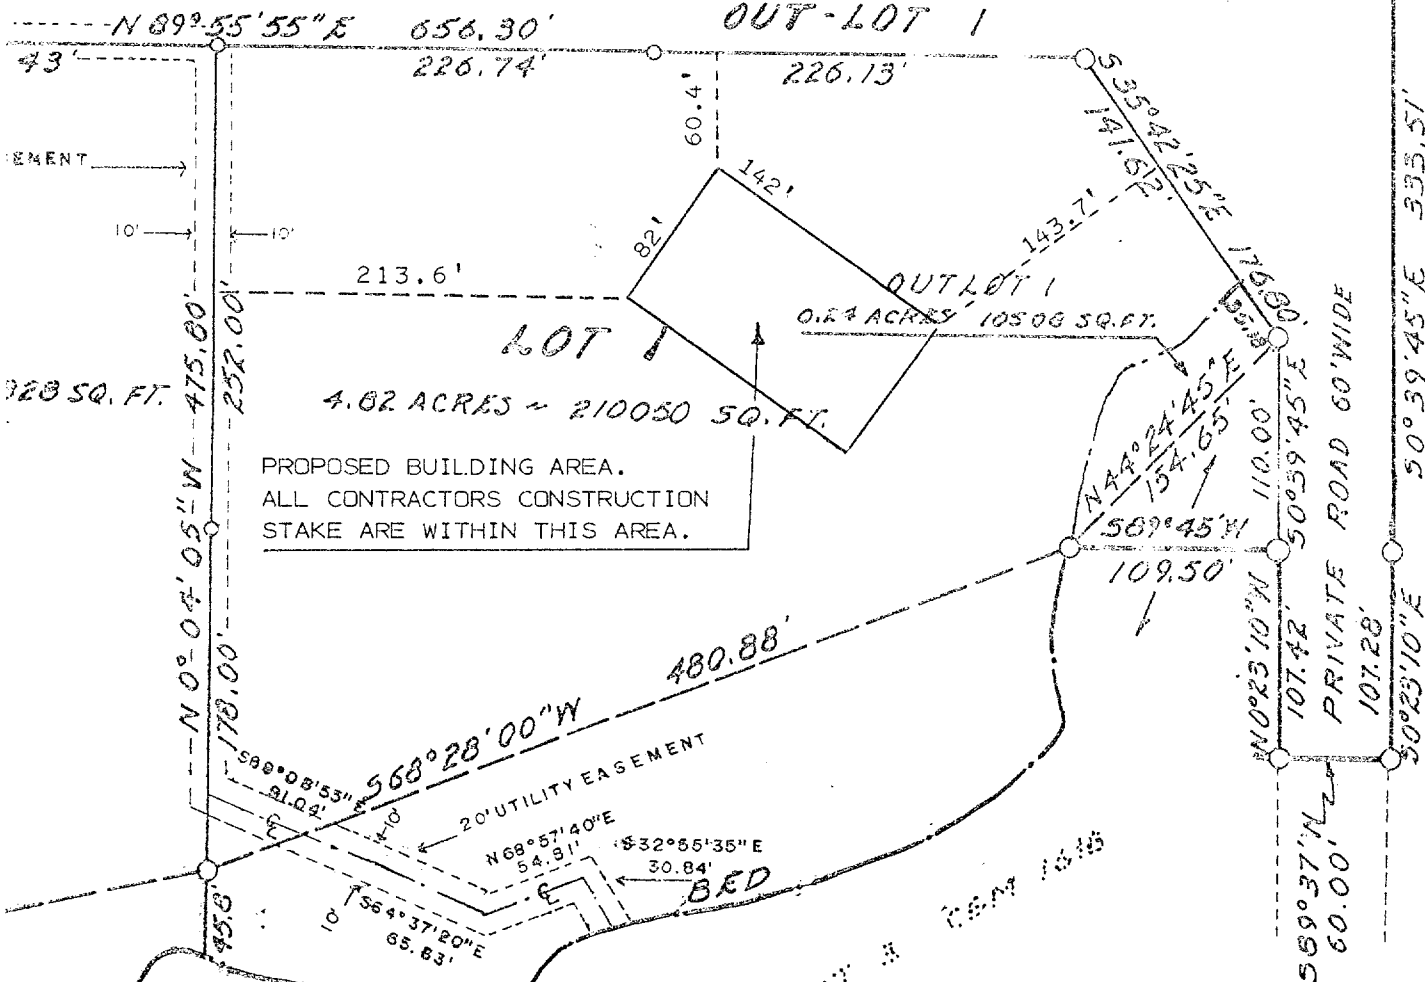


PLAT OF SURVEY OF
PROPOSED BUILDING LOCATION ON LOT 1, OAK BLUFFS,
A SUBDIVISION LOCATED IN THE NORTHWEST 1/4 OF
SECTION 11, T 1 N, R 16 E, TOWN OF WALWORTH,
WALWORTH COUNTY, WISCONSIN.

HAROLD H. KOLB
WISCONSIN REGISTERED LAND SURVEYOR, S-187

DATE: June 10, 1991

ORDERED BY: DENNIS JACOBSON
100 SEAHORSE DRIVE
WAUKEGAN IL 60085

LOCATION DRAWING

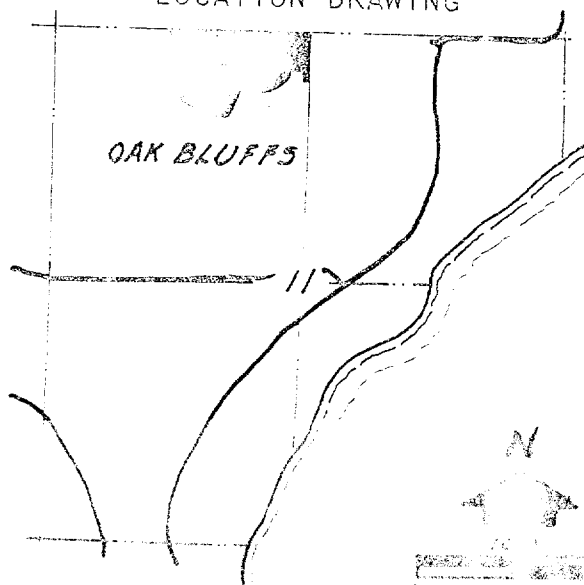

KOLB LAND CONSULTING, INC.
LAND SURVEYING • SUBDIVIDING • LAND PLANNING