


WEST LINE OF
THE EAST 1/2
OF THE SW 1/4
OF SECTION 16,
T1N, R16E - 2

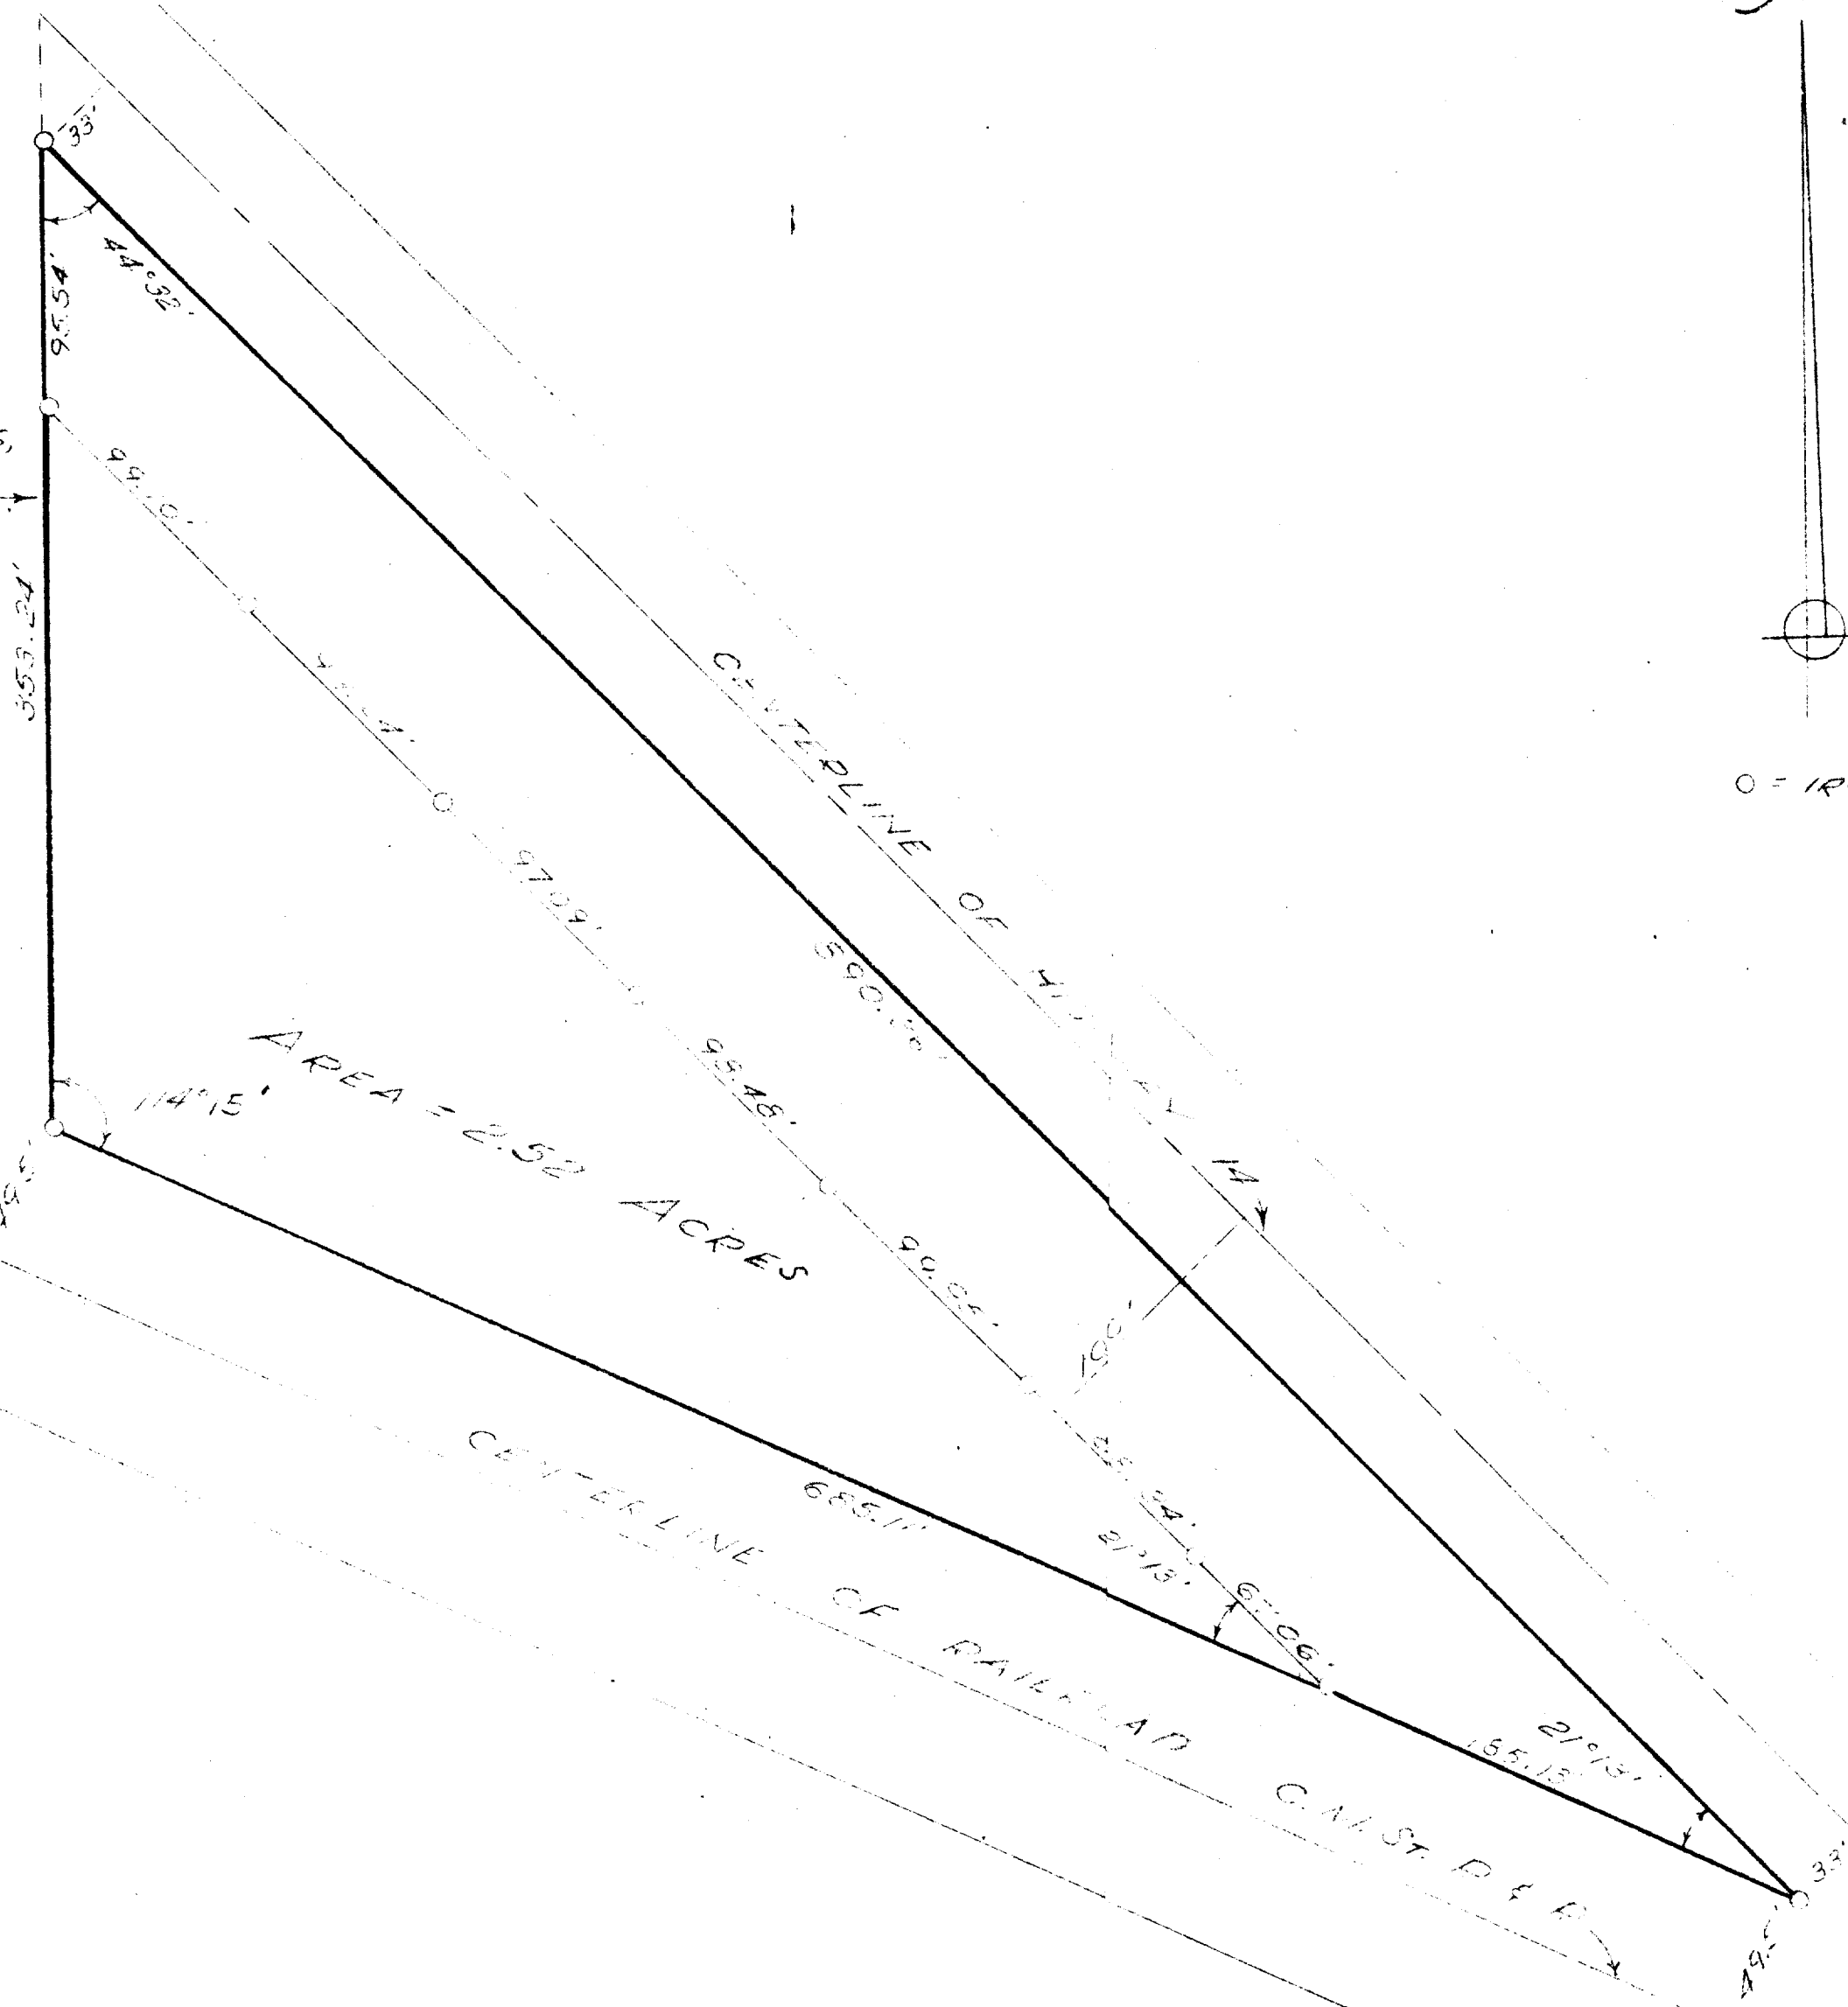

O = IRON PIPE

W-16-13A Now C.S 1680

116-33.1

PLAT OF SURVEY OF

LAND LOCATED IN THE EAST
1/2 OF THE SOUTHWEST 1/4 OF
SECTION 16, T1N, R16E IN
WALWORTH COUNTY, WISCONSIN

Lloyd Jensen
SURVEYOR

SCALE 1" = 60'

DATE AUGUST 1958