

PLAT OF SURVEY OF
LOT 2 OF CERTIFIED SURVEY MAP NO. 1849 LOCATED
IN THE NORTHEAST 1/4 OF SECTION 11, T1N, R16E,
TOWN OF WALWORTH, WALWORTH COUNTY, WISCONSIN.

ORDERED BY: RUSSELL HOVDE
RT. 1 BOX 636B
FONTANA, WI 53125


NOTE: BEARINGS ARE ASSUMED AS SHOWN
ON CERTIFIED SURVEY MAP NO. 1849.

SCALE 1"=50'
LEGEND
 ✕ - IRON PIPE FOUND
 G - GARAGE
 CS - CONCRETE STOOP
 * - CYCLONE FENCE
 () - AS RECORDED

I HEREBY CERTIFY THAT I HAVE SURVEYED THE ABOVE DESCRIBED PROPERTY AND THAT THE ABOVE MAP IS A TRUE REPRESENTATION THEREOF AND SHOWS THE SIZE AND LOCATION OF THE PROPERTY, ITS EXTERIOR BOUNDARIES, THE LOCATION OF ALL VISIBLE STRUCTURES AND THE DIMENSIONS OF ALL PRINCIPAL BUILDINGS THEREON, BOUNDARY FENCES, APPARENT EASEMENTS, ROADWAYS AND VISIBLE ENCROACHMENTS, IF ANY, TO THE BEST OF MY KNOWLEDGE AND BELIEF.

THIS SURVEY IS MADE FOR THE USE OF THE PRESENT OWNERS OF THE PROPERTY, AND ALSO THOSE WHO PURCHASE, MORTGAGE, OR GUARANTEE THE TITLE THERETO WITHIN ONE (1) YEAR FROM DATE HEREON.

THIS SURVEY IS NOT VALID UNLESS THE SURVEYOR'S SIGNATURE IS IN RED.

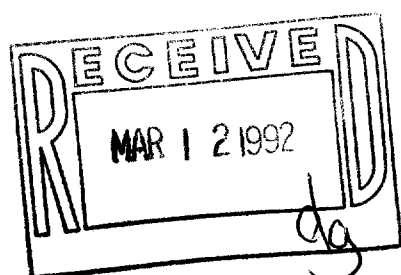

HAROLD H. KOLB
WISCONSIN REGISTERED LAND SURVEYOR, S-187
DATE JUNE 25, 1990
REVISED _____