
ABELL SURVEYING & MAPPING

DELAVAN. WISCONSIN 53115 414-728-6737



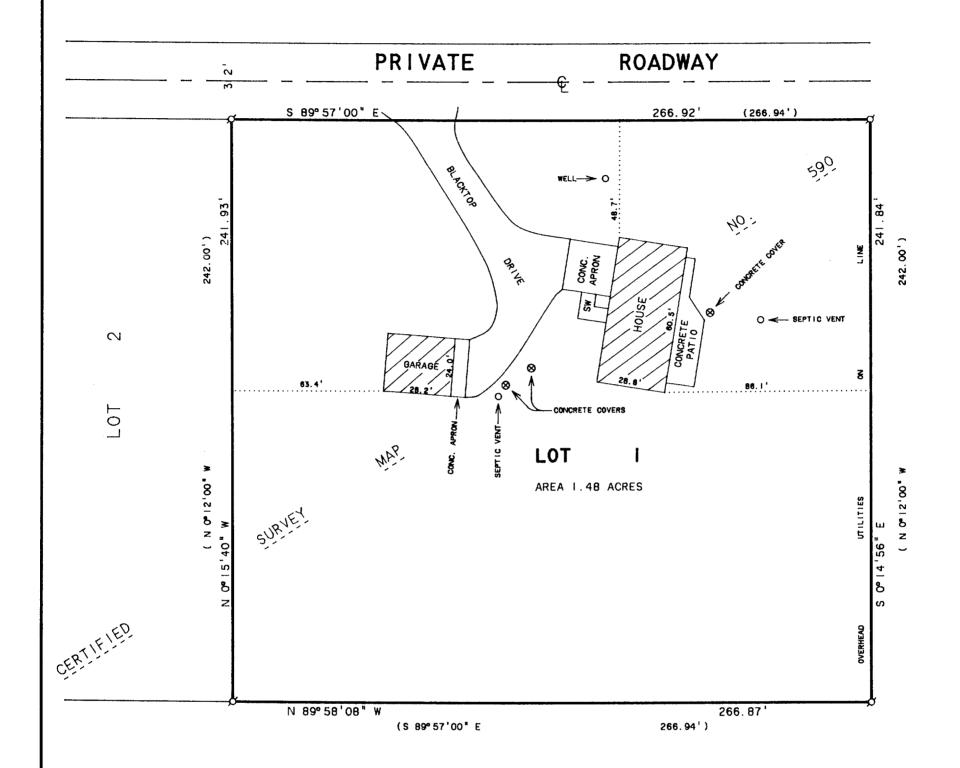


LEGEND

Ø -IRON PIPE FOUND)-RECORDED AS

PLAT OF SURVEY OF

LOT I, CERTIFIED SURVEY MAP NO. 590. LOCATED IN THE SOUTHWEST 1/4 OF SECTION

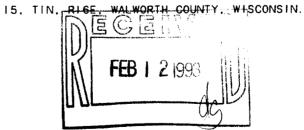

I HEREBY CERTIFY THAT I HAVE SURVEYED THE ABOVE DESCRIBED PROPERTY AND THAT THE ABOVE MAP IS A TRUE REPRESENTATION THEREOF AND SHOWS THE SIZE AND LOCATION OF THE PROPERTY. ITS EXTERIOR BOUNDARIES. THE LOCATION OF ALL VISIBLE STRUCTURES AND DIMENSIONS OF ALL PRINCIPAL BUILDINGS THEREON. BOUNDARY FENCES. APPARENT EASEMENTS. ROADWAYS AND VISIBLE ENCROACHMENTS. IF ANY, TO THE BEST OF MY KNOWLEDGE AND BELIEF.

THIS SURVEY IS MADE FOR THE USE OF THE PRESENT OWNERS OF THE PROPERTY. AND ALSO THOSE WHO PURCHASE, MORTGAGE, OR GUARANTEE THE TITLE THERETO WITHIN ONE (I) YEAR FROM DATE HEREON.

DAVID F. ABELL WISCONSIN REGISTERED LAND SURVEYOR, S-1596

ORDERED BY: THE RAULAND AGENCY P.O. BOX 159 WALWORTH, WI. 53184

NOTE: BEARINGS ARE REFERENCED TO

CERTIFIED SURVEY MAP NO. 590.

November 11, 1992

DATE JOB NUMBER - 92250

NOTE: THIS IS NOT A CERTIFIED COPY UNLESS SEALED.