

929 WILLIAMS STREET LAKE GENEVA, WISCONSIN 53147 414-248-3697



N 89° 55' 55" E
 226.74'
 10'
 10'
 245.2'
 475.80'
 252.00'
 N 0° 04' 05" W
 178.00'
 45.8'
 S 69° 08' 55" E 91.04'
 S 68° 28' 00" W 10'
 N 68° 57' 40" E 54.81'
 S 32° 55' 35" E 30.84'
 S 64° 37' 20" E 65.83'
 DRY
 20' UTILITY EASEMENT
 480.88'
 C.S.M. NO. 1618.
 SEPTIC VENT
 CONC. MANHOLE
 SEPTIC VENT
 CABIN
 CENTERLINE OF A 10 FOOT PEDESTRIAN EASEMENT ALONG "DRY CREEK BED" AS SHOWN ON
 LOT 1
 CONC. DRIVE
 DECK
 CONC. PATIO
 HOUSE
 WELL
 186.4'
 82.6'
 452.87'
 226.13'
 BLACKTOP DRIVE
 S 35° 42' 25" E 176.80'
 141.62'
 N 44° 24' 45" E 154.65'
 BED
 COUTLOT 1 OF OAK BLUFFS SUBD.
 95.18'
 LOT 3
 C.S.M. 1618
 PRIVATE ROAD 60' WIDE
 SCALE: 1" = 100'
 ORDERED BY: DENNIS JACOBSON
 100 SEASHORE DRIVE

ORDERED BY: DENNIS JACOBSON
100 SEASHORE DRIVE
WAUKEGAN, ILL. 60085

NOTE: BEARINGS ARE ASSUMED AS SHOWN ON
CERTIFIED SURVEY MAP NO. 1618.

LOT 1 OF OAK BLUFFS A SUB-DIVISION OF LOT 4 OF CERTIFIED SURVEY MAP NO. 1618, LOCATED IN THE NORTHEAST 1/4 OF THE NORTHWEST 1/4 OF SECTION 11, T1N, R16E, TOWN OF WALWORTH, WALWORTH COUNTY, WISCONSIN.

I HEREBY CERTIFY THAT I HAVE SURVEYED THE ABOVE DESCRIBED PROPERTY AND THAT THE ABOVE MAP IS A TRUE REPRESENTATION THEREOF AND SHOWS THE SIZE AND LOCATION OF THE PROPERTY, ITS EXTERIOR BOUNDARIES, THE LOCATION OF ALL VISIBLE STRUCTURES AND DIMENSIONS OF ALL PRINCIPAL BUILDINGS THEREON, BOUNDARY FENCES APPARENT EASEMENTS, ROADWAYS AND VISIBLE ENCHROACHMENTS, IF ANY TO THE BEST OF MY KNOWLEDGE AND BELIEF.

THIS SURVEY IS MADE FOR THE USE OF THE PRESENT OWNERS OF THE PROPERTY, AND ALSO THOSE WHO PURCHASE, MORTGAGE, OR GUARANTEE THE TITLE THERETO WITHIN ONE (1) YEAR FROM DATE HEREOF. SURVEY NOT VALID UNLESS SURVEYOR'S SIGNATURE IS IN RED.


HAROLD H. KOLB

WISCONSIN REGISTERED LAND SURVEYOR, S-187

DATE APRIL 13, 1993

REVISÉD

REVISÉD

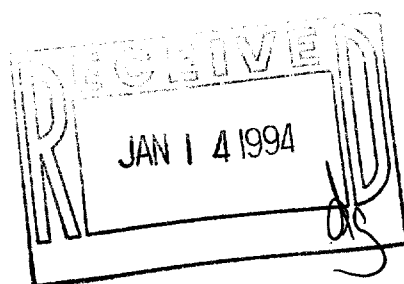

116-390