


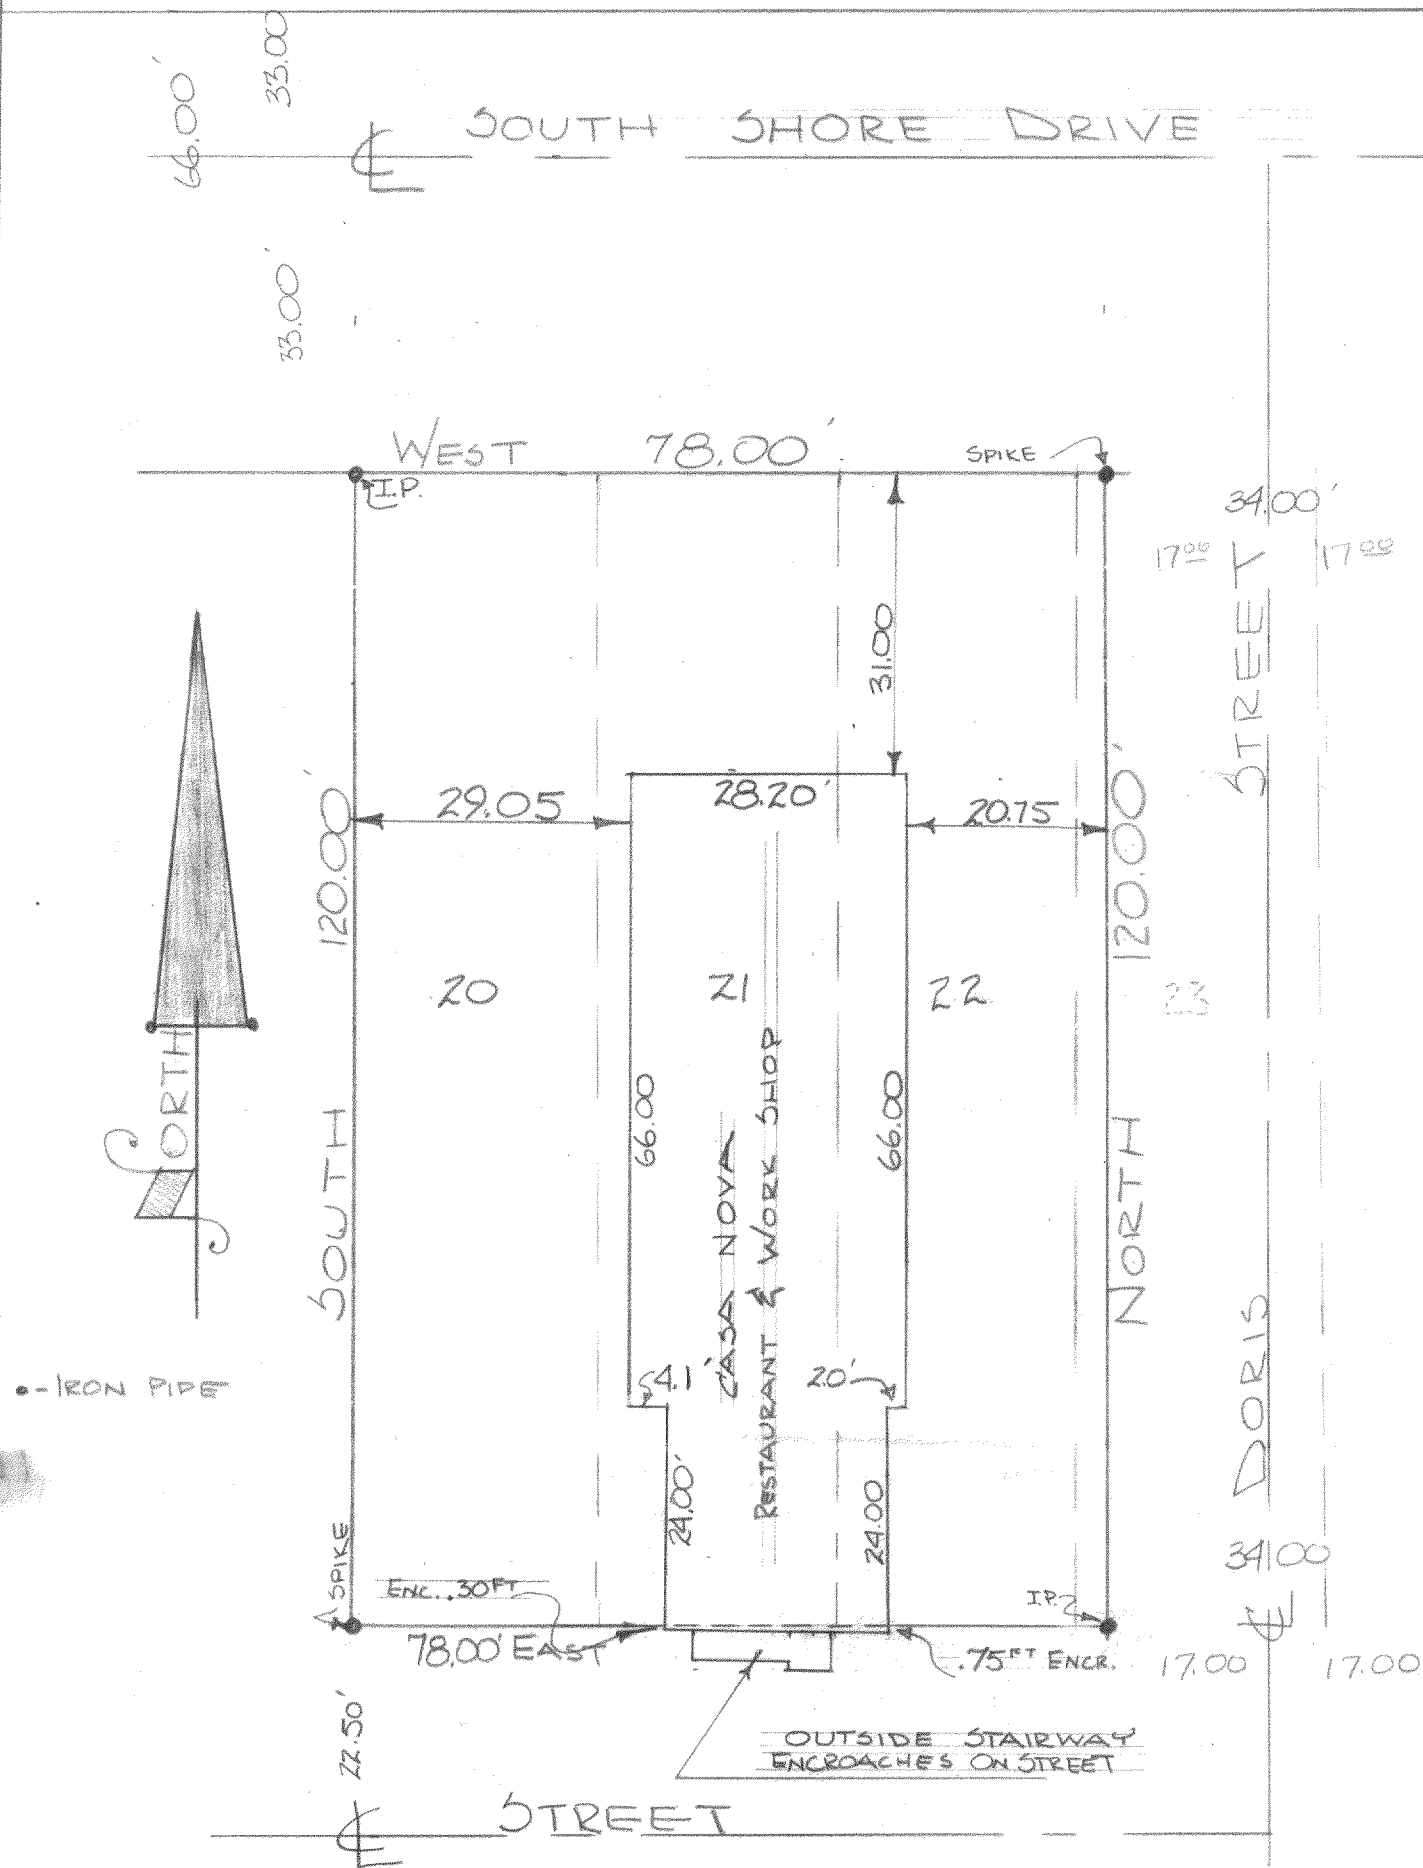

DESCRIPTION: Lots 20, 21, 22, and the West 3.00 feet of Lot 23 in Block # 4 of Robbins Subdivision, T. 1N., R. 16 E., Walworth County, Wisconsin.

CERTIFICATE: I, James F. Biagi, Surveyor, do hereby certify that I have surveyed the property hereon described and that the location of the improvements are as shown on the drawing above.

July 3, 1961



James F. Biagi
James F. Biagi, (RIS 272)