

Plat of Survey

of

Lot 3 of Certified Survey Map No. 998,

recorded in Vol. 4 of Certified Survey Maps of Walworth County on Page 269 and located in the Northeast 1/4 of Section 17, Town 1 North, Range 16 East, Town of Walworth, Walworth County, Wisconsin.

Surveyed for: **Terry Schaid**
P.O. Box 153
Walworth, Wisconsin. 53184-0153

Lot 2
C.S.M. 2139

Lot 3
(5.003 Acres)
4.995 Acres
217,580 Sq.Ft.


4.769 Acres
207,741 Sq.Ft.
Exclusive of R.O.W.

Lot 4
C.S.M. 2139

Lot 4
C.S.M. 998

Notes: 1) This survey plat is not certified unless signed and sealed in red ink.

2) This survey is subject to Wisconsin lien laws. This Plat of Survey is the notice of intent to file lien. Lien waiver required.

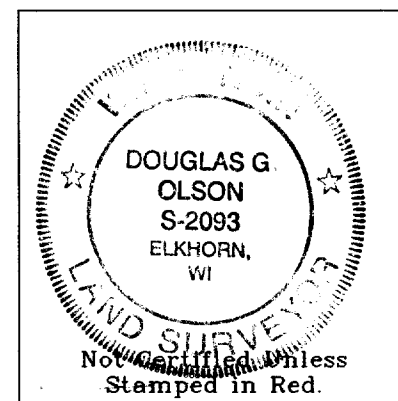

Copyright © 2003 by Jensen & Olson Land Surveying, LLC.

All rights reserved. No part of this survey plat may be reproduced or transmitted in any form by any means, graphic, electronic, or mechanical, including photocopying, tracing, or information storage and retrieval systems, without permission in writing from Douglas G. Olson, Jensen & Olson Land Surveying, LLC.

I, Douglas G. Olson, Wisconsin Registered Land Surveyor, do hereby certify that this survey was performed by me or under my direction in full compliance with the owner's/agent's instructions and Chapter A-E 7 of the Wisconsin Administrative Code "Minimum Standards for Property Surveys"; and that this map is an accurate representation thereof to the best of my knowledge and belief.

Douglas G. Olson
Wisconsin Registered Land Surveyor - 2093

Northeast Corner
Section 17-1-16.
(N. 204,573.16)
(E. 2,372,063.88)

East line of the Northeast 1/4 of Section 17-1-16.
S1°40'55"E 300.09'
(S1°42'00"E 300.02')

Six Corners Road (66' Wide)

East 1/4 Corner
Section 17-1-16.
(N. 201,963.13)
(E. 2,372,152.62)

SEP 18 2003

kw

Survey Date: July 8, 2003.
Revisions: No. 1 - Asbuilt Shed

Scale in Feet
1" = 40'

Jensen & Olson Land Surveying, LLC
45 South Wisconsin Street
Elkhorn, Wisconsin. 53121
Telephone (262) 723-3434
Facsimile (262) 723-8044

Legend
Found County Section Corner
Found Iron Pipe
Set Wood Stake
Recorded Information
Septic Vent
Utility Pole
Asphalt Surface
Concrete

Sheet 1 of 1 Sheets
Job Reference Number
2003.105

2003.105