

PLAT OF SURVEY

WORK ORDERED BY -
JOHN LINCOLN
W6980 SAVANNAH LANE
DELANA, WI 53115

FARRIS, HANSEN & ASSOCIATES, INC.
Engineering, Architecture, Surveying
7 Ridgway Court P.O. Box 437
ELKHORN, WISCONSIN 53121
Office: (262) 723-2098
Fax: (262) 723-5886


REVISIONS
6/6/2007-KB
TO SHOW SIZE
AND LOCATION
OF EXISTING
RESIDENCE &
PROPOSED
GARAGE

PROJECT NO.
4633.09
DATE:
04/27/2000
SHEET NO.
1 OF 1

PLAT OF SURVEY

LOT 9 OF DEER PATH ESTATES

LOCATED IN THE SE & SW 1/4'S OF THE SE 1/4
OF SECTION 6, TOWN 1 NORTH, RANGE 16 EAST,
TOWN OF WALWORTH, WALWORTH COUNTY, WISCONSIN

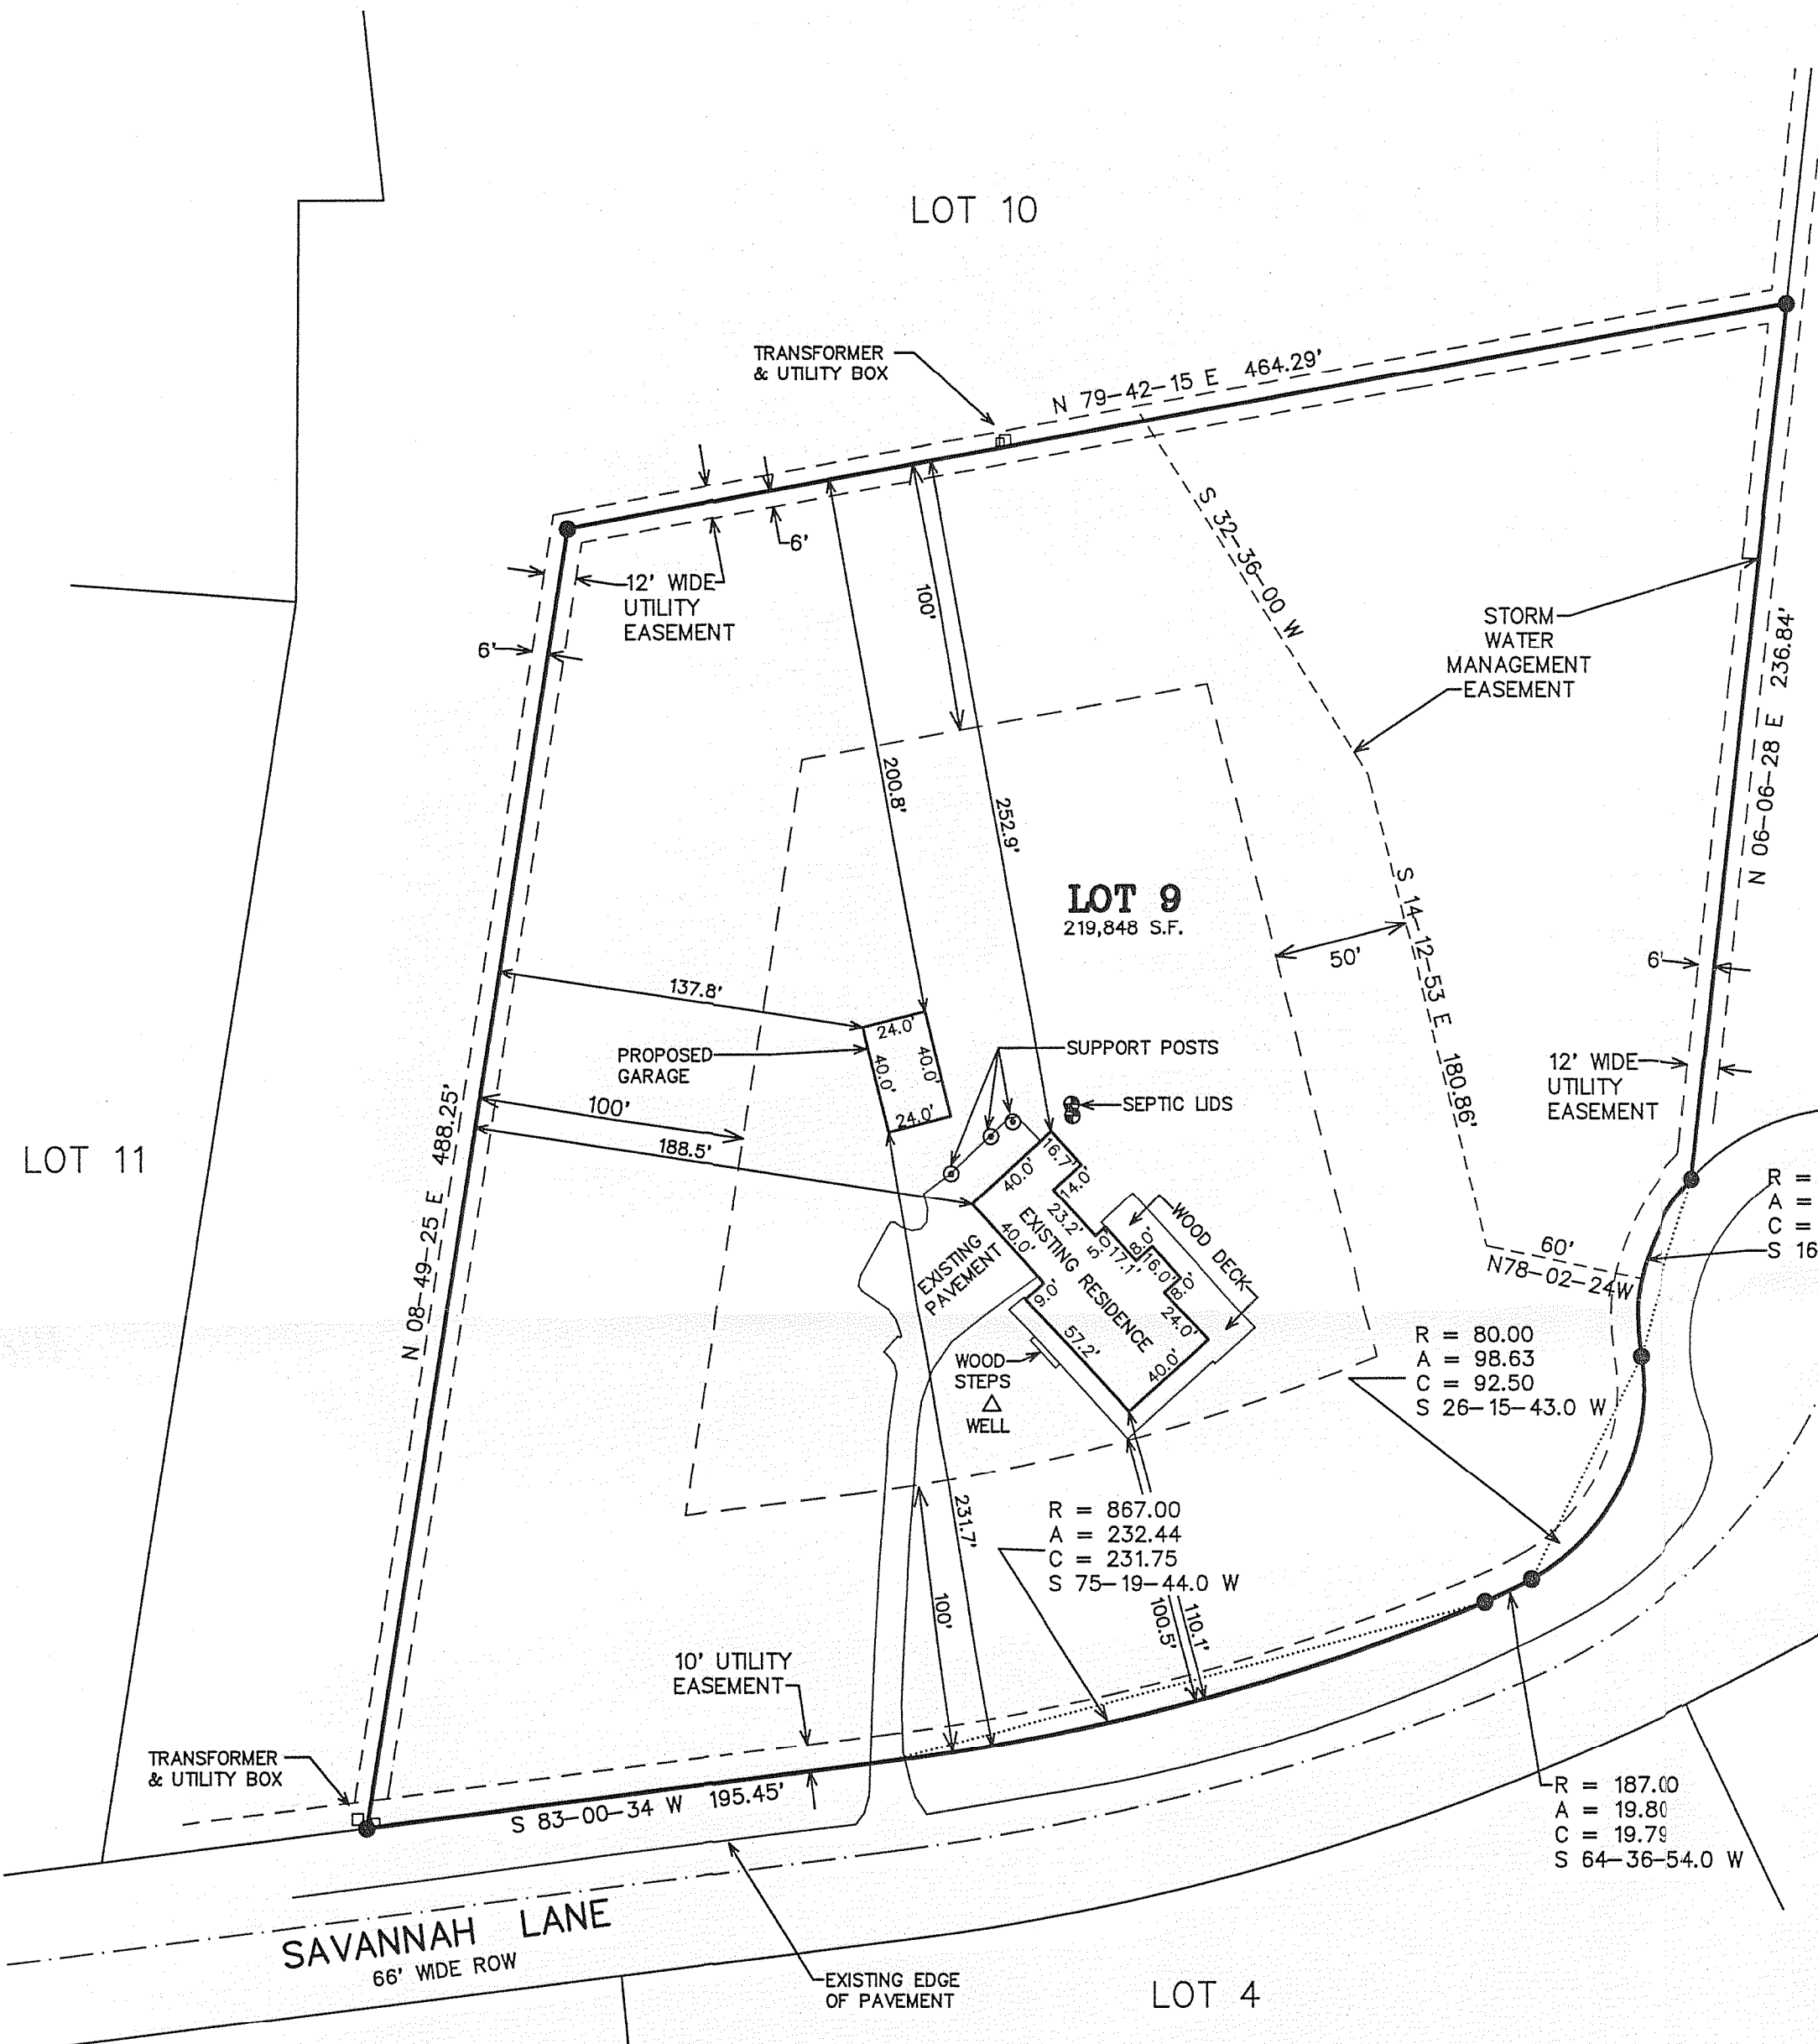

LOT 9
219,848 S.F.

LOT 8

LOT 7

LOT 6

LOT 5

LOT 4

LOT 3

LOT 11

LOT 10

LOT 1

LOT 2

LOT 3

LOT 279

<