
ABELL SURVEYING & MAPPING

1140 SEQUOIA STREET • DELAVAN. WISCONSIN 53115 262-728-6737

> (NORTHEAST CORNER OF THE WEST 1/2 OF THE SOUTHWEST 1/4 OF SECTION 5, TIN,R16E)

NORTH WALWORTH ROAD

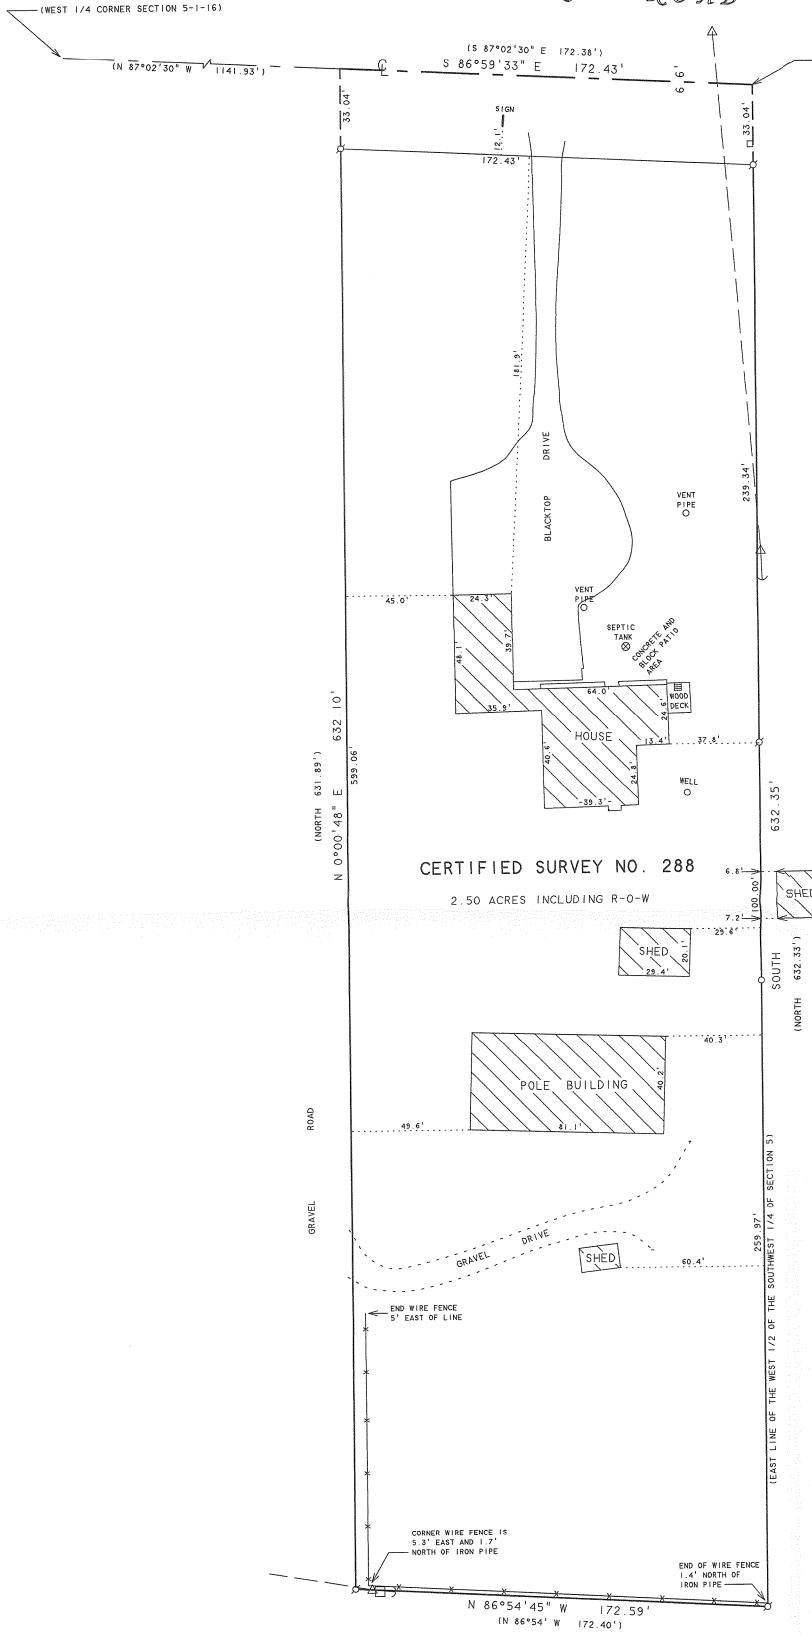

PLAT OF SURVEY OF

CERTIFIED SURVEY NO. 288, LOCATED IN THE WEST 1/2 OF THE SOUTHWEST 1/4 OF SECTION 5, TOWN I NORTH, RANGE 16 EAST, TOWN OF WALWORTH, WALWORTH COUNTY, WISCONSIN.

ORDERED BY: GORDY LOEPKE
OWNER: MARLIES LOEPKE
W6807 NORTH WALWORTH ROAD
WALWORTH. WI 53184

BEARINGS ARE REFERENCED TO CERTIFIED SURVEY NO. 288





SCALE | " = 40 1

LEGEND

Ø - IRON PIPE FOUND
Ø - IRON PIPE SET
△ - UTILITY POLE
→ - GUYWIRE
- - OVERHEAD UTILITY LINES
□ - UTILITY PEDS
- WIRE FENCE
() - RECORDED AS



I HEREBY CERTIFY THAT I HAVE SURVEYED THE ABOVE DESCRIBED PROPERTY AND THAT THE ABOVE MAP IS A TRUE REPRESENTATION THEREOF AND SHOWS THE SIZE AND LOCATION OF THE PROPERTY. ITS EXTERIOR BOUNDARIES. THE LOCATION OF ALL VISIBLE STRUCTURES AND DIMENSIONS OF ALL PRINCIPAL BUILDINGS THEREON, BOUNDARY FENCES, APPARENT EASEMENTS, ROADWAYS AND VISIBLE ENCROACHMENTS, IF ANY, TO THE BEST OF MY KNOWLEDGE AND BELIEF.

THIS SURVEY IS MADE FOR THE USE OF THE PRESENT OWNERS OF THE PROPERTY, AND ALSO THOSE WHO PURCHASE, MORTGAGE, OR GUARANTEE THE TITLE THERETO WITHIN ONE (I) YEAR FROM DATE HEREON.

Land 7. All

DAVID F. ABELL WISCONSIN REGISTERED LAND SURVEYOR, S-1596

August 13, 2008

DATE JOB NUMBER - 08032 NOTE: THIS IS NOT A CERTIFIED COPY UNLESS SEALED.