
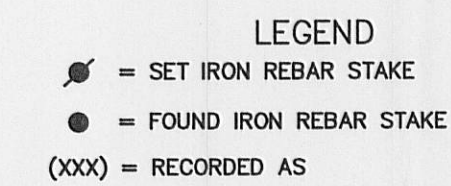


LOT 1 OF CERTIFIED SURVEY MAP NO. 3624  
LOCATED IN PART OF THE NE 1/4 AND SE 1/4 OF SECTION 35,  
AND PART OF THE NW 1/4 OF SECTION 36, TOWN 1 NORTH,  
RANGE 16 EAST, WALWORTH COUNTY, WISCONSIN

Lot 1 of Certified Survey Map No. 3624, recorded October 29, 2003 in Volume 21 of Certified Surveys, on page 249 as Document No. 581749, located in Sections 35 and 36, Town 2 North, Range 16 East, Town of Walworth, Walworth County, Wisconsin.

Tax Key Number: EA362400001

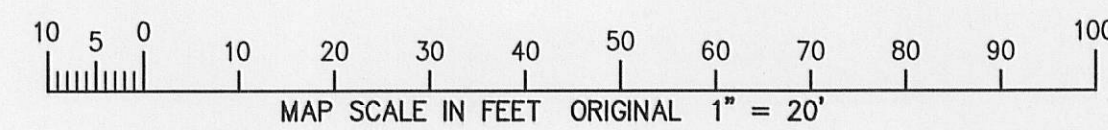

I HEREBY CERTIFY THAT THE ABOVE DESCRIBED PROPERTY HAS BEEN SURVEYED UNDER MY DIRECTION AND THAT THE ABOVE MAP IS A TRUE REPRESENTATION THEREOF AND SHOWS THE SIZE AND LOCATION OF THE PROPERTY, ITS EXTERIOR BOUNDARIES, THE LOCATION OF ALL VISIBLE STRUCTURES, AND DIMENSIONS OF ALL FRONTS OF THE BUILDING THEREON, THE LOCATION OF ALL APPURTENANCES, ROADS, AND VISIBLE ENCROACHMENTS, IF ANY. THIS SURVEY IS MADE FOR THE USE OF THE PRESENT OWNERS OF THE PROPERTY, AND ALSO THOSE WHO PURCHASE, MORTGAGE, OR GUARANTEE THE TITLE, THERETO WITHIN ONE YEAR FROM THE DATE HEREOF.

PETER S. GORDON R.L.S. 2101

WISCONSIN  
PETER S.  
GORDON  
S-2101  
ELKHORN,  
WI  
LAND SURVEYOR

WORK ORDERED BY:  
KEEFE REAL ESTATE  
PO BOX 460  
LAKE GENEVA, WI. 53147

**STARKIS, HANSEN & ASSOCIATES, INC.**  
ENGINEERING — ARCHITECTURE — SURVEYING

7 RIDGWAY COURT P.O. BOX 437  
ELKHORN, WISCONSIN 53121  
OFFICE: (262) 723-2098 FAX: (262) 723-

## REVISIONS

PROJECT NO.  
6281.11

DATE  
03-17-2011

SHEET NO.  
1 OF 1