

SURVEYING & SUBDIVIDING
DEHAVAN, WISCONSIN 53115





● = 2" Iron Pipe Found
 ♂ = 1" Iron Pipe Found
 ○ = 1½" X 30" Iron Pipe Set

R. 4, Box 362
Delavan, WI 53115

Ø = 3/4" Iron Pipe Set

Lots 9-15 inclusive in Addition No. 1 to Robbins Subdivision,
located in Section 5, T 1 N, R 16 E, Walworth County, Wisconsin,
and that the plat shown hereon is a correct representation thereof and shows
the size and location of the property, its exterior boundaries, the location
of all visible structures and dimensions of all principal buildings thereon,
boundary fences, apparent easements, roadways and visible encroachments, if
any, and that I have surveyed the property hereon described, according to the
official records, to the best of my knowledge and belief.
July 2, 1991

George T. Dunham
George T. Dunham, Surveyor

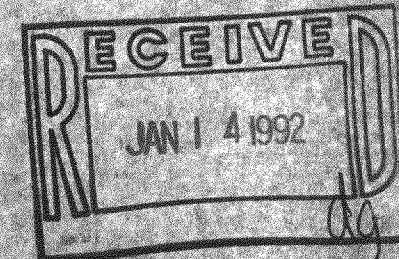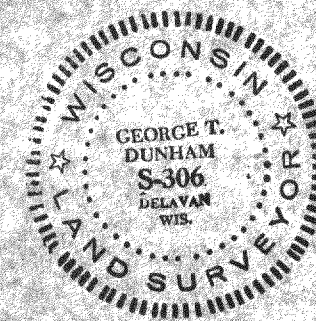

ERA-9
ERA-10
ERA-11
ERA-12