


**ABELL
SURVEYING & MAPPING**
1140 SEQUOIA STREET
DELAVAN, WISCONSIN
414-728-6737

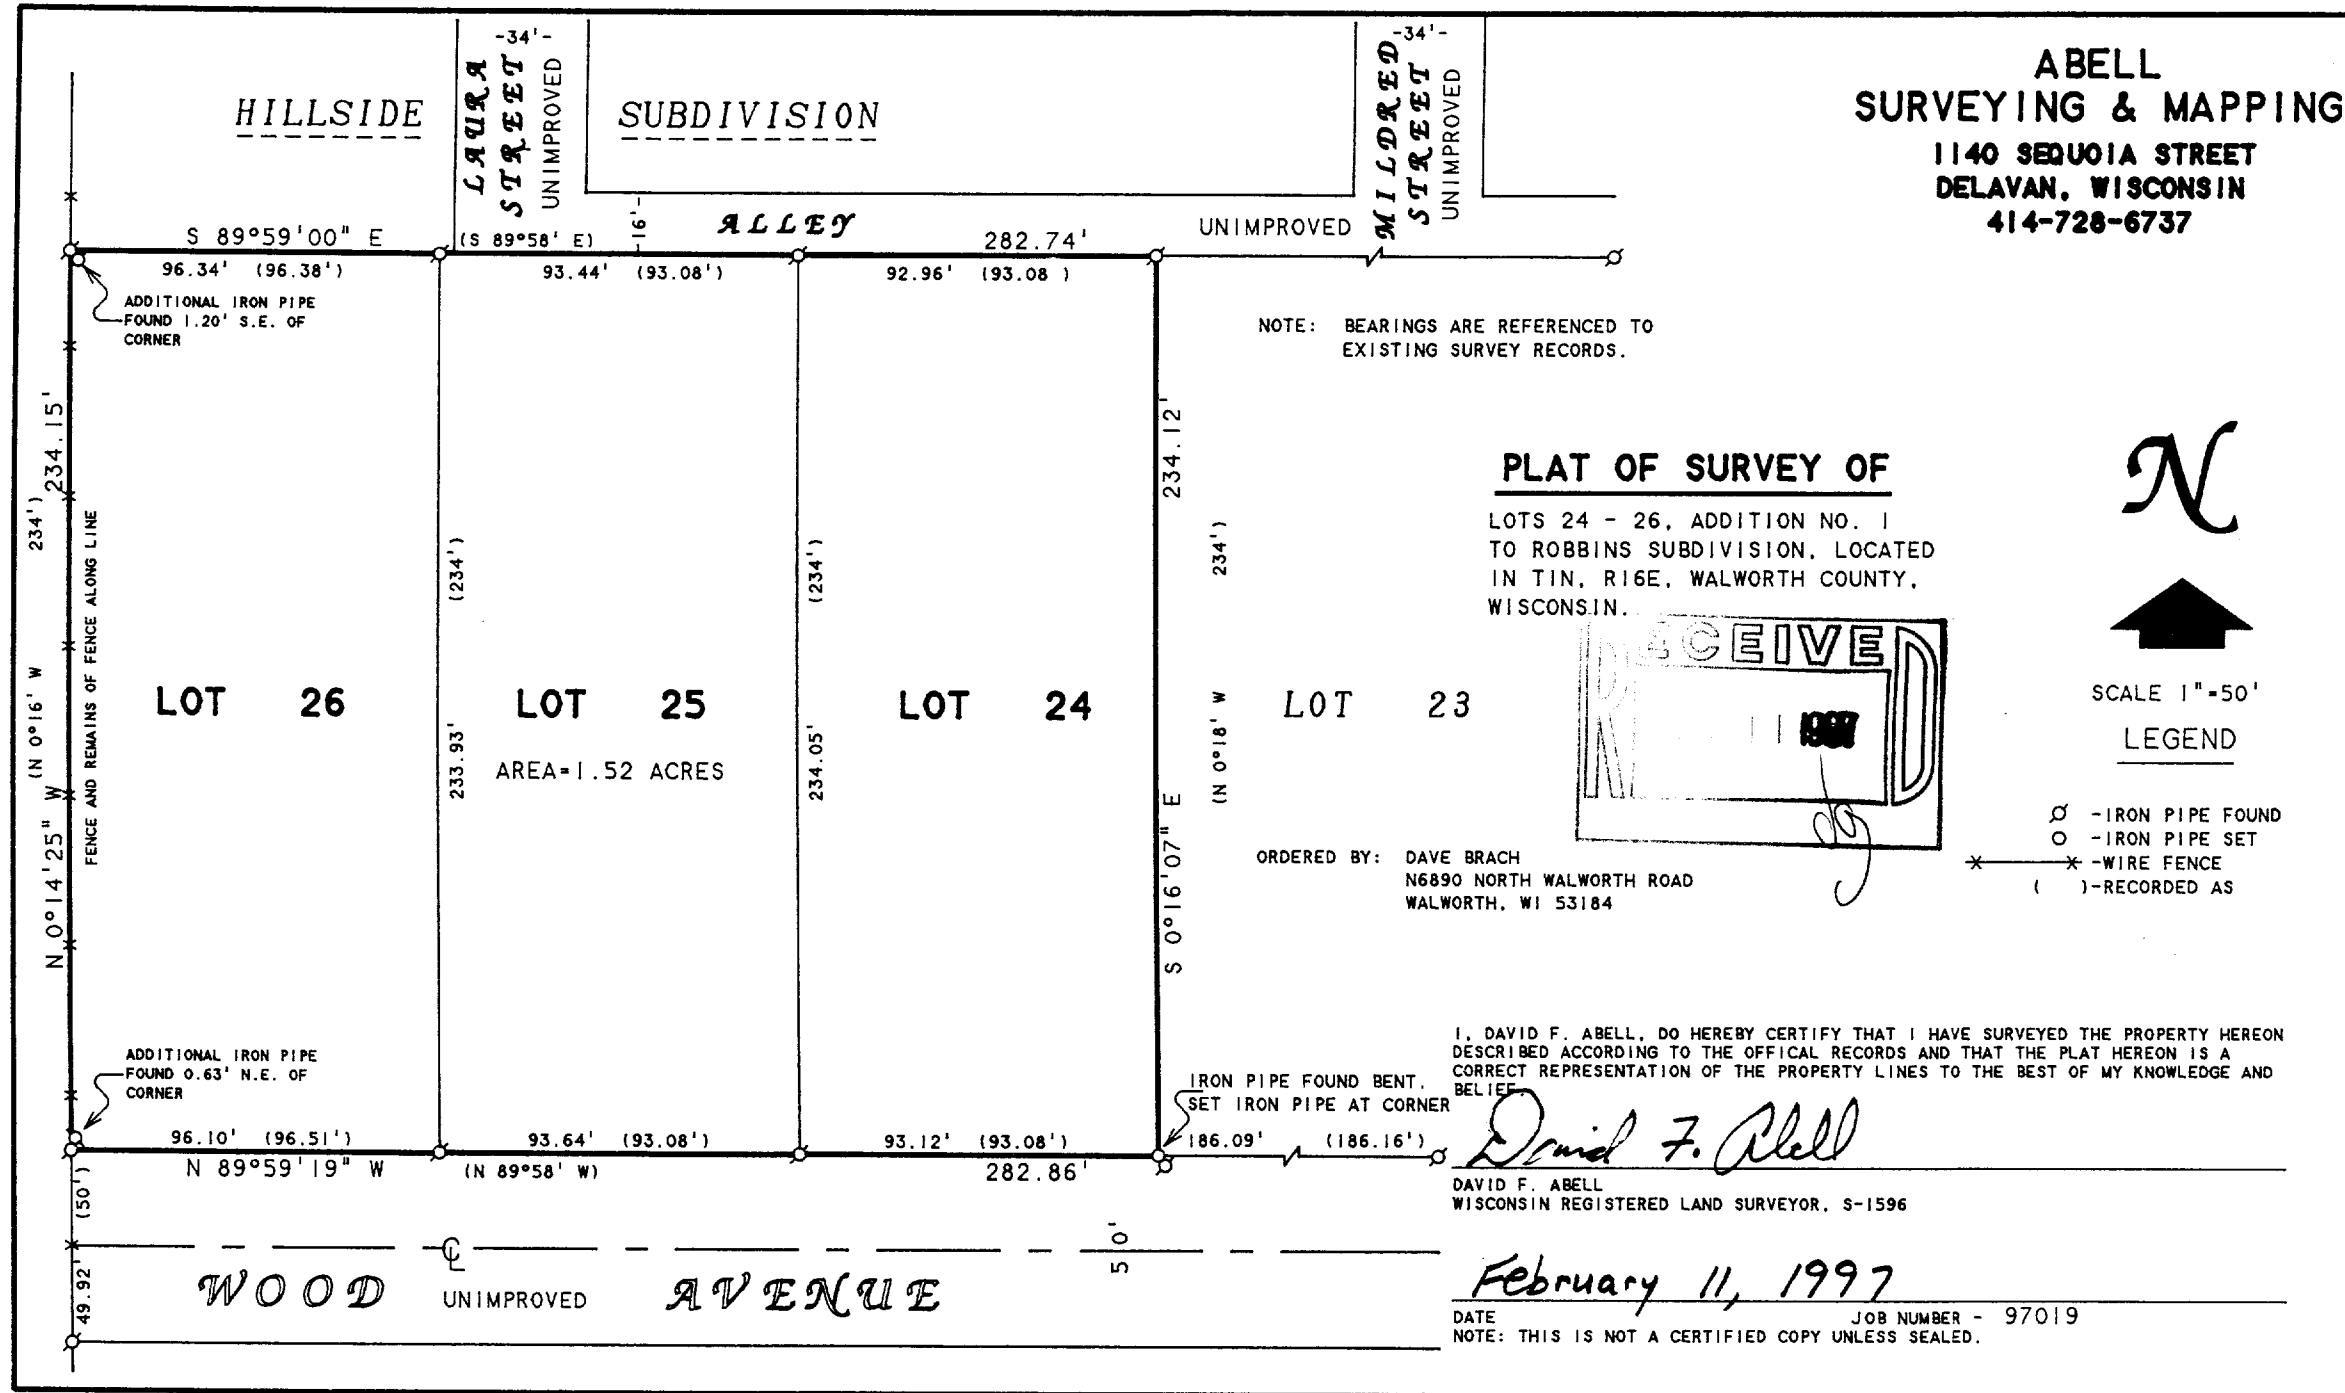

ERA-24
ERA-25
ERA-26

116-466