

# Plat of Survey

of


Surveyed for: **Brett & Amy Polyock**  
W7269 Brick Church Road  
Walworth, Wisconsin. 53184

## Lot 1 of Certified Survey Map No. 4630,

recorded in Vol. 30 of Certified Survey Maps of Walworth County on Page 237  
and located in the Northwest 1/4 of the Southwest 1/4 of Section 18, Town 1  
North, Range 16 East, Town of Walworth, Walworth County, Wisconsin.

No. 6 - 3' Added to House  
Addition

Survey Date: November 28, 2017.  
Revisions: No. 1 - Tullable Area  
No. 2 - County Topo  
No. 3A - Proposed Building  
No. 4 - Addition  
No. 5 - House, As-Built  
As-Built

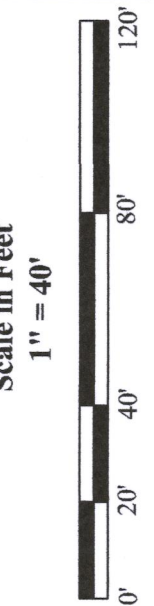


45 South Wisconsin Street P.O. Box 322  
Elkhorn, Wisconsin 53121  
Telephone: (262) 723-3434  
Facsimile: (262) 723-8044  
Email: doug@olsonsurveying.com  
Website: www.olsonsurveying.com

**OLSON**  
LAND SURVEYING, LLC  
Rural | Residential | Commercial

Legend of Symbols & Abbreviations  
Found County Section Corner  
Recorded Information  
Utility Pole  
Asphalt Surface  
Concrete Surface  
Brick Pavers, Patio Blocks or Stone

Sheet 1 of 1 Sheets  
Drawing Name:  
Job Reference Number  
2020.076

2020.076

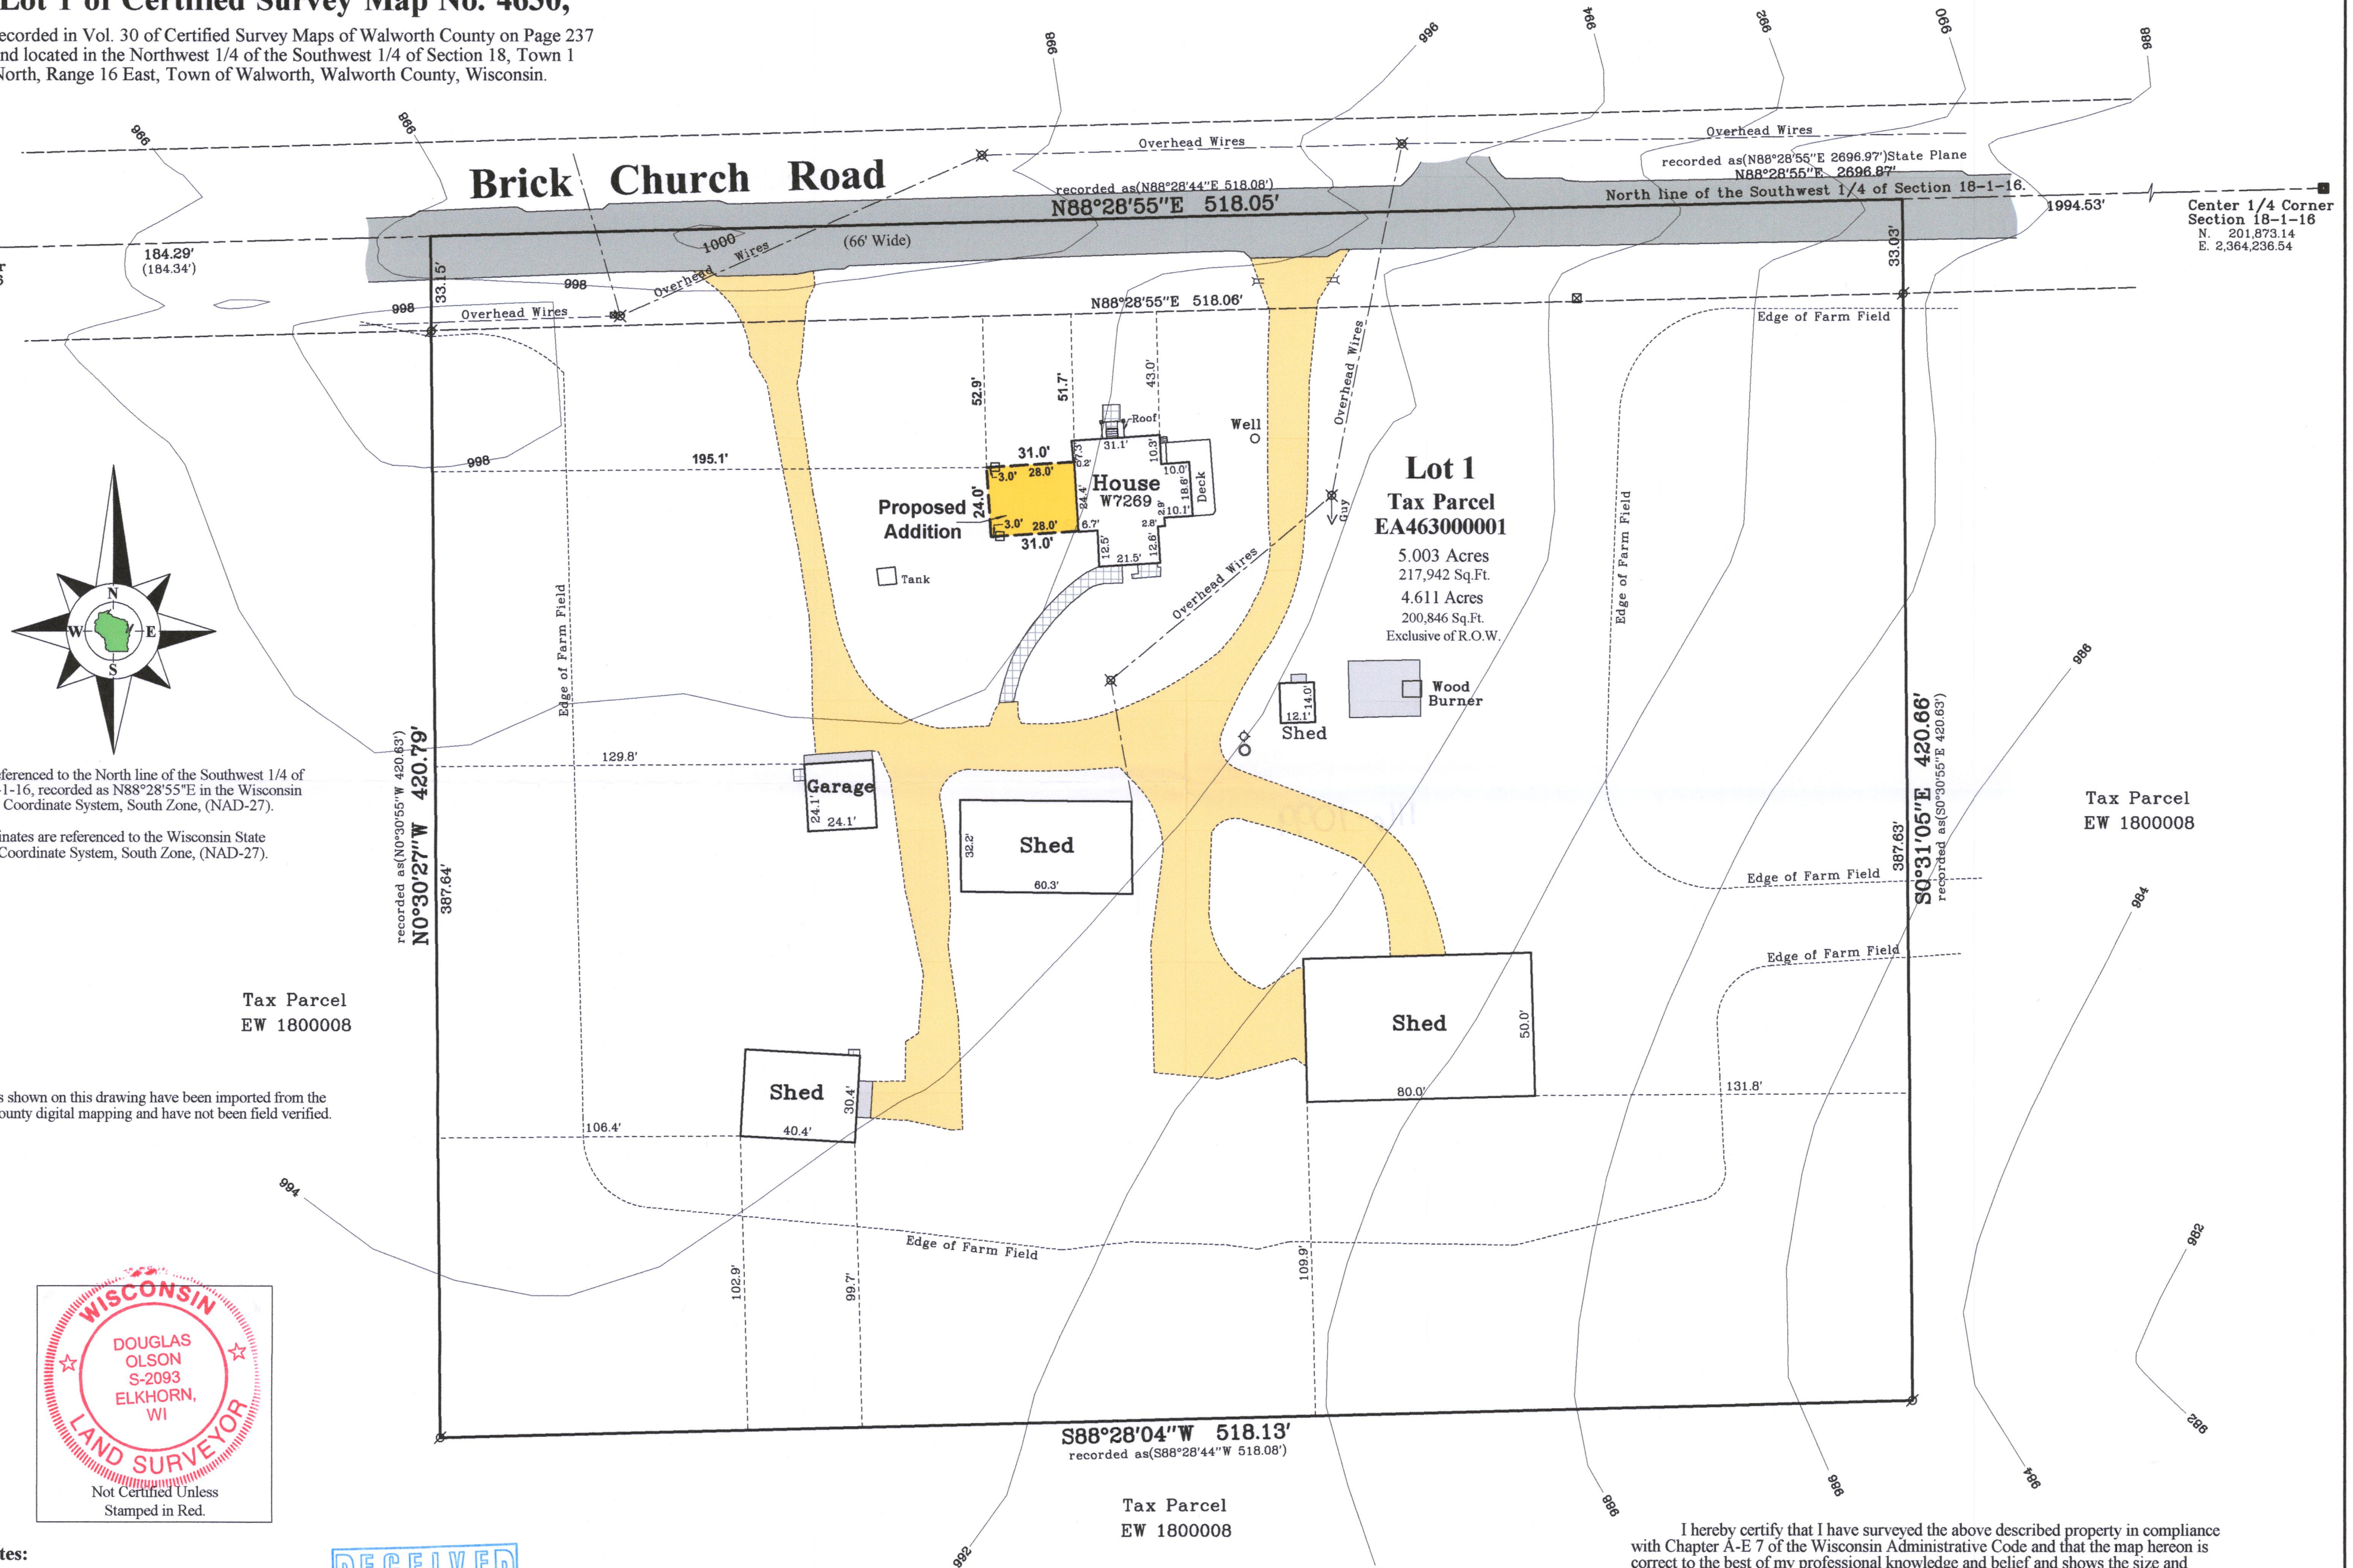


Bearings referenced to the North line of the Southwest 1/4 of  
Section 18-1-16, recorded as N88°28'55"E in the Wisconsin  
State Plane Coordinate System, South Zone, (NAD-27).

Coordinates are referenced to the Wisconsin State  
Plane Coordinate System, South Zone, (NAD-27).

Tax Parcel  
EW 1800008


### Note:

The contours shown on this drawing have been imported from the  
Walworth County digital mapping and have not been field verified.

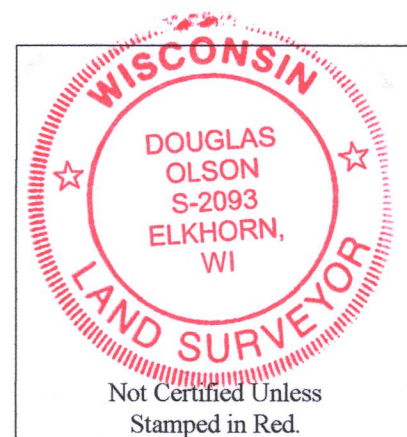

### Notes:

- This Plat of Survey is not certified unless signed and sealed in red ink.
- This survey is subject to Wisconsin lien laws. This Plat of Survey is the notice of intent to file lien. Lien waiver required.
- The Survey Date shown on this Plat of Survey is the completion date of the field work.

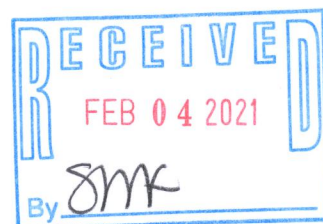

Copyright ©2017 by Olson Land Surveying, LLC.

All rights reserved. No part of this survey plat may be reproduced or transmitted in any form by any means - graphic, electronic, or mechanical, including photocopying, tracing, or information storage and retrieval systems - without permission in writing from Douglas G. Olson, Olson Land Surveying, LLC.

I hereby certify that I have surveyed the above described property in compliance with Chapter A-E 7 of the Wisconsin Administrative Code and that the map hereon is correct to the best of my professional knowledge and belief and shows the size and location of the property, its exterior boundaries, the location and dimensions of all visible structures thereon, boundary fences, apparent easements and roadways and visible encroachments, if any.

This survey is made for the exclusive use of the present owners of the property, and also those who purchase, mortgage or guarantee title thereto, within one year from the date hereof.

Douglas G. Olson  
Wisconsin Professional Land Surveyor - 2093