


PLAT

OF SURVEY

200,42,00%E

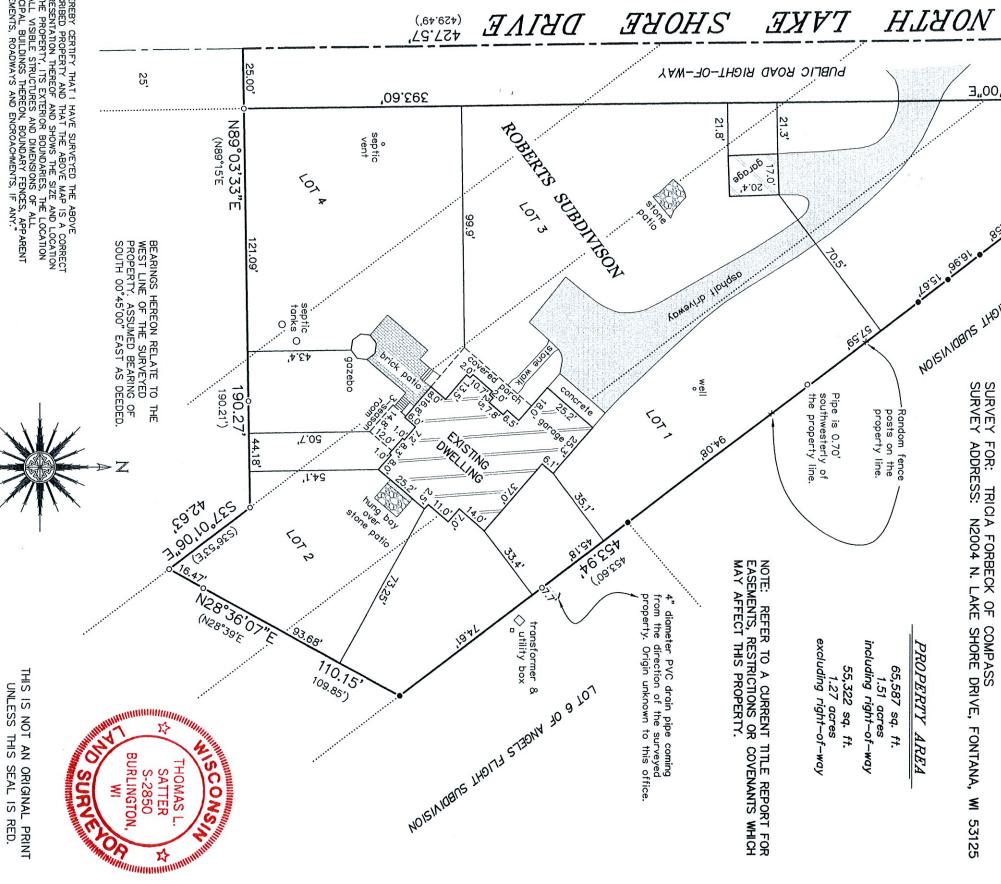

SATTER SURVEYING, LLC
LAND SURVEYS, MAPPING AND PLANNING
272 ORIGEN STREET
BURLINGTON, WI 53105
262-661-4239

SCALE:

40

REVISED: 6/8/23 FEBRUARY 2, 2018 DATE

011807 B NUMBER

20,

-80

THOMAS

Thomas 7.

atter

S-2850

"THIS SURVEY IS MADE FOR THE USE OF THE PRESENT OWNERS OF THE PROPERTY, AND THOSE WHO PURCHASE, MORTGAGE, OR GUARANTEE THE TITLE THERETO WITHIN ONE YEAR FROM DATE HERETOF."