Plat of Survey


Lots 48 & 49 of Hillside,

a subdivision located in the Northwest 1/4 of the Northwest 1/4 of Section 5, Town 1 North, Range 16 East, Town of Walworth, Walworth County, Wisconsin.


Surveyed for:

Gerald Julius

808 S. Evergreen Avenue Arlington Heights, Illinois. 60005

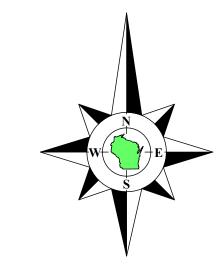

Bearings referenced to the North line of the Northwest 1/4 of Section 5-1-16, recorded as N88°28'56"E in the Wisconsin State Plane Coordinate System,

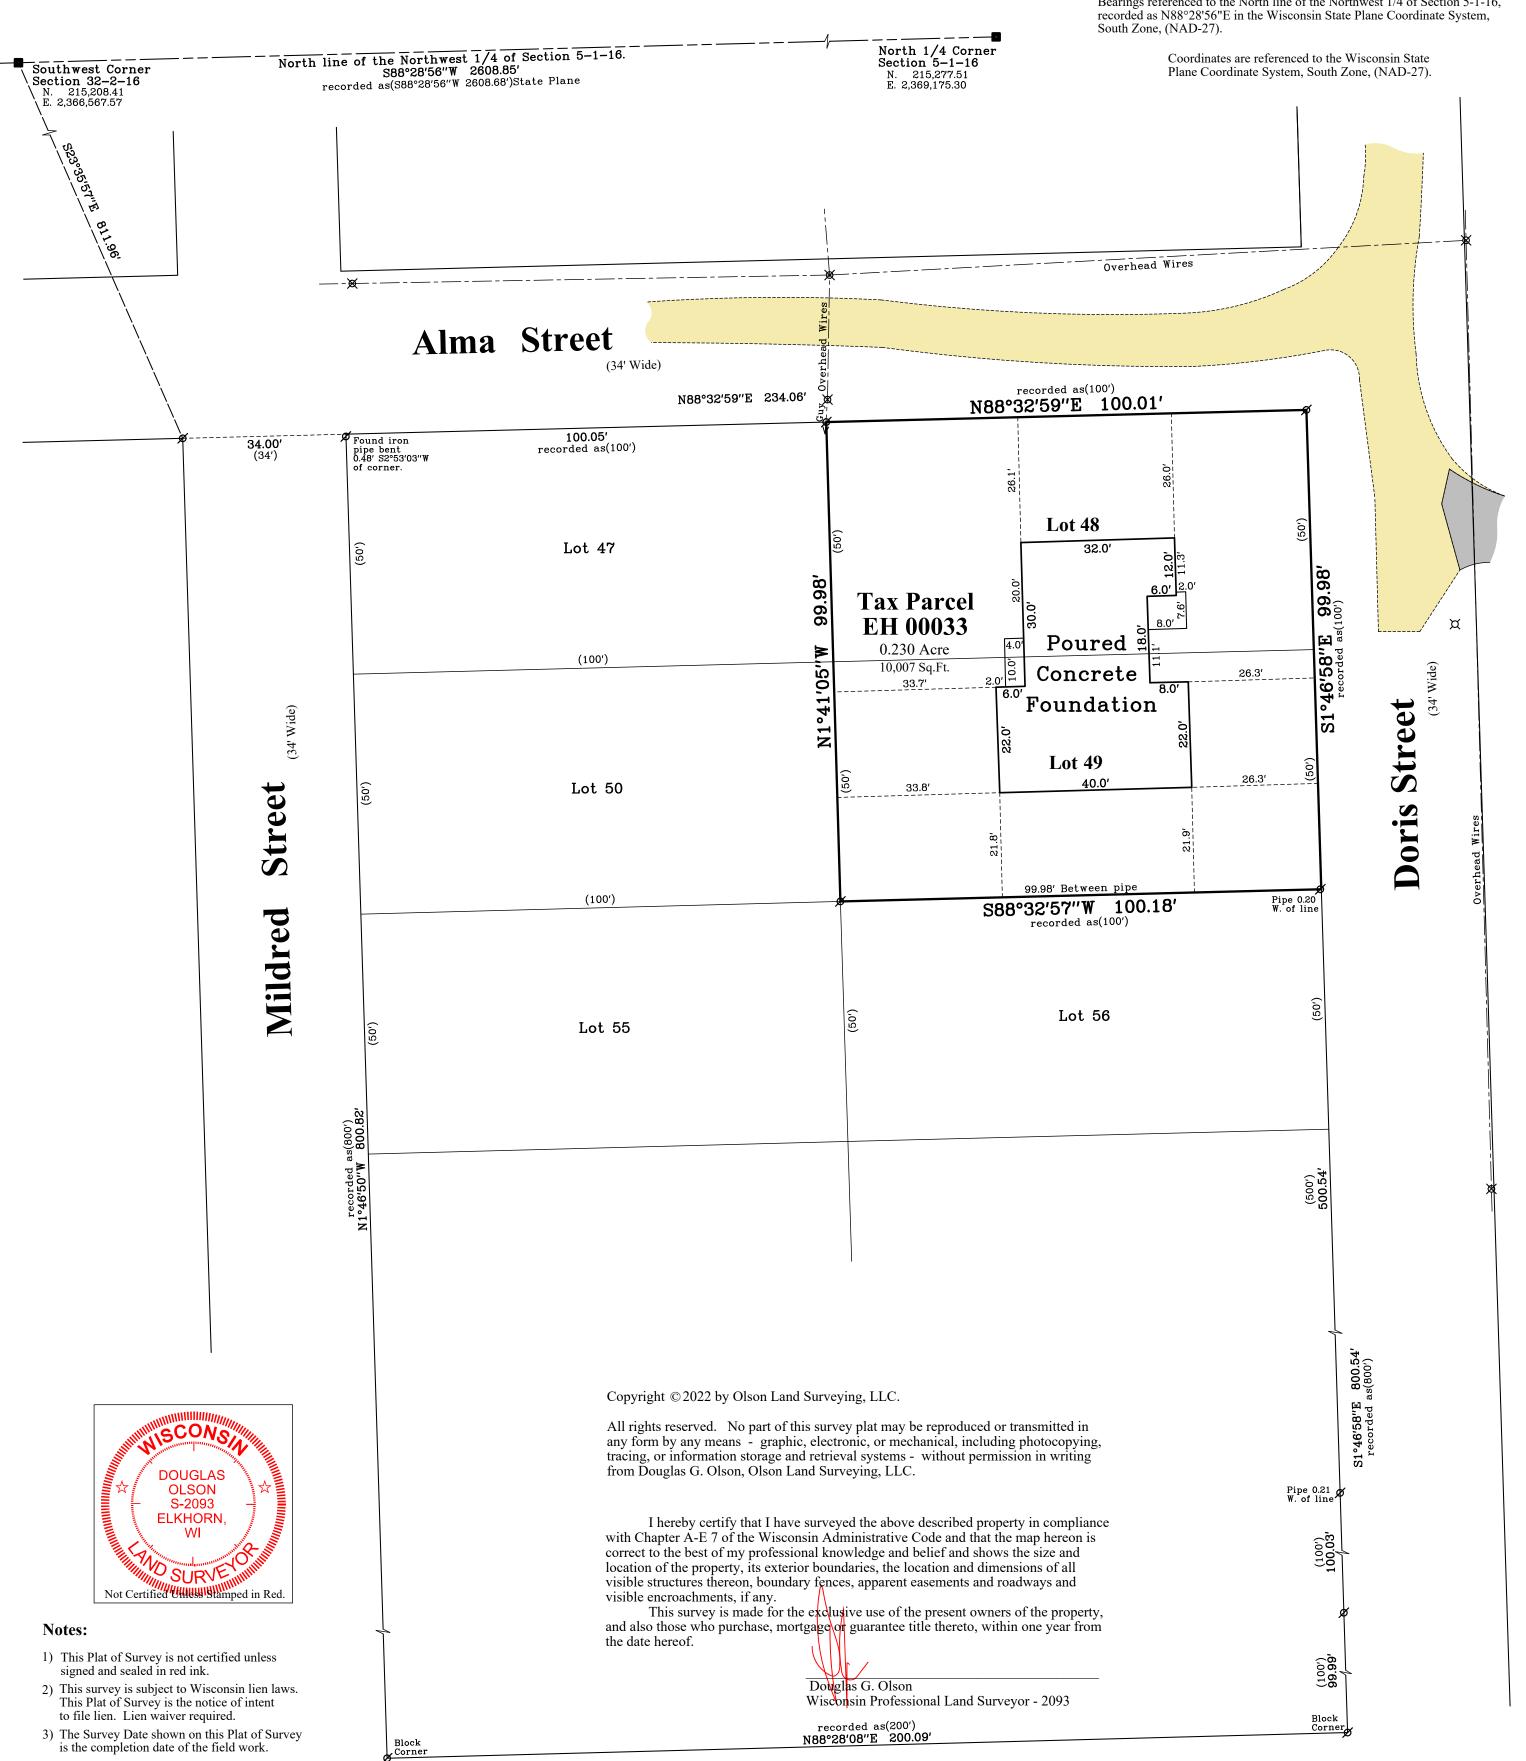

2022.117

Sheet 1 of 1 Sheets

Drawing Name: **Job Reference Number**

2022.117

Legend of Symbols & Abbreviations

Found County Section Corner

Found Iron Pipe

() Recorded Information

W Utility Pole

Utility Pedestal

Concrete Cover


Septic Vent

Asphalt Surface

Gravel Surface

N North
S South
E East
W West
In Bearings
Degrees
Minutes " Seconds
In Distances
' Feet
" Inches Residential | Commercial Rural |

45 South Wisconsin Street | P.O. Box 322 Elkhorn, Wisconsin. 53121 Telephone: (262) 723-3434 Facsimile: (262) 723-8044 Email: doug@olsonsurveying.com Website: www.olsonsurveying.com

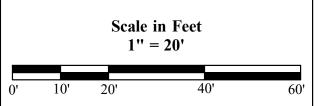

Survey Date: September 30, 2022

Revisions: No. 1 - Proposed House No. 2 - Revised Proposed House
No. 3 - Poured Concrete
Foundation