


# MORTGAGE INSPECTION SURVEY

LOTS 117, 118, 119, & 120 OF HILLSIDE SUBDIVISION, TOWN OF WALWORTH, WALWORTH CO. WIS.

NOTE: This is not a "Property Survey" as defined in Sec. AE-5.01 of the Wisconsin Administrative Code.

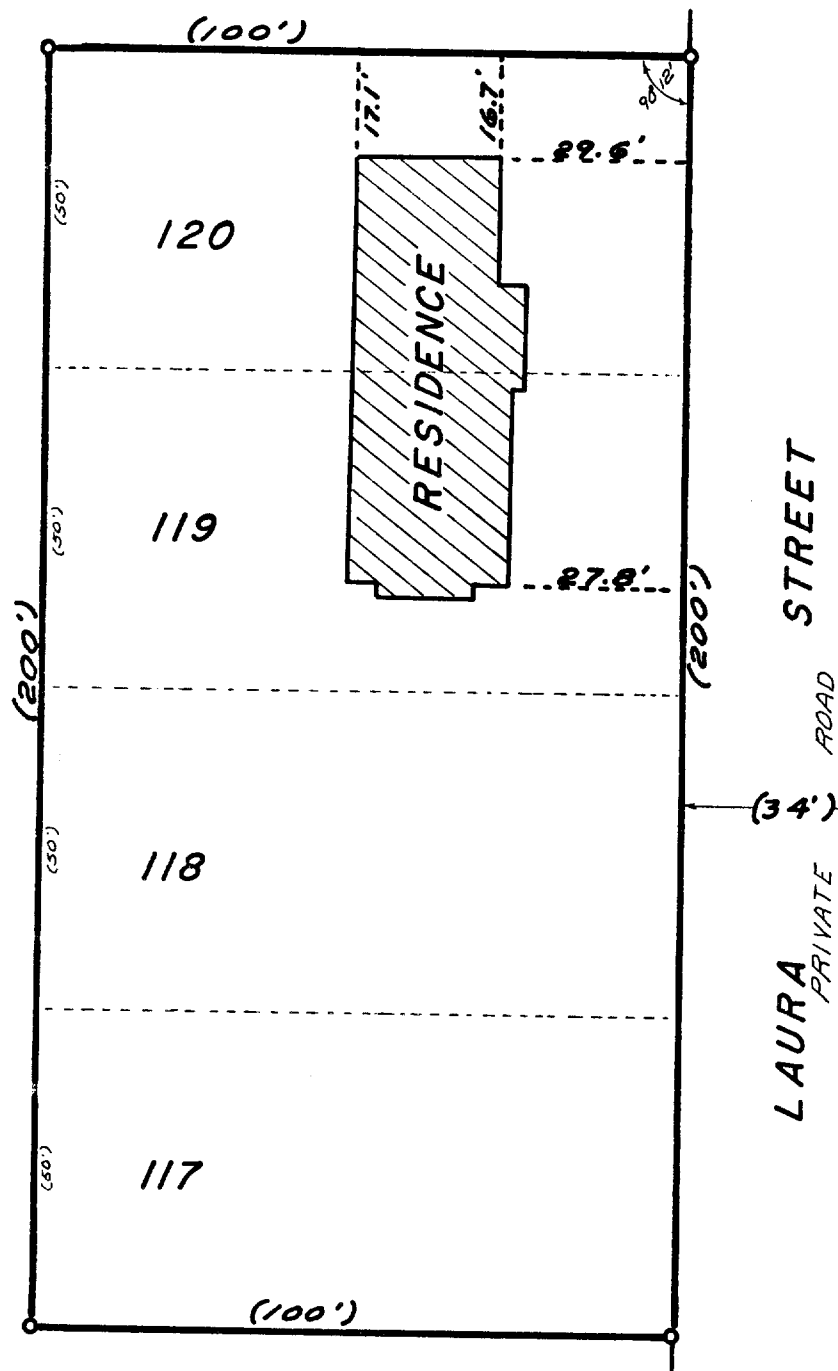


SCALE 1"=30'

( ) = Record Dimension  
o = Found Iron Pipe

Buyer: Neil E. Steiert  
Seller: Joseph R. Zindrick  
Property Address: Rt. 4, Bx 319-B  
Delavan, Wis.

Work Ordered By: Waukesha Savings  
& Loan Association -- East Troy

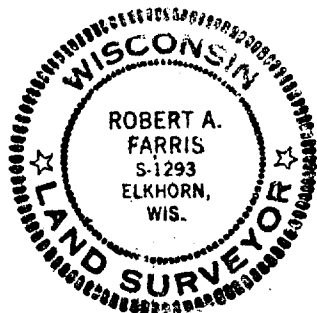

I HEREBY CERTIFY that this map is a true and accurate representation of the lot lines and of the building located thereon to the best of my professional knowledge and belief.

*Robert A. Farris*

Robert A. Farris RLS

Dated this 5th day of October 1978

FARRIS, HANSEN & COOPER, INC.  
715 W. Walworth St. P.O. Box 487  
Elkhorn, WI 53121

DRAWING NO. 1413

111-153