



ANDERSON LAND SURVEYING

DEHAVAN, WIS. 53115

728-2525

PLAT OF SURVEY

DESCRIPTION: All of Lots 117, 118, 119, and 120 of Hillside Sub-division located in the NW.1/4 of the NW.1/4 of Sec.5, T.1 N., R.16 E., of the 4th. P.M., Town of Walworth, Walworth Co., Wis.

PREPARED FOR:


Neil E. Steiert

PREPARED BY:

Anderson Land
Surveying
Delavan, WI

SCALE: 1" = 30'

○ = IRON PIPE FOUND

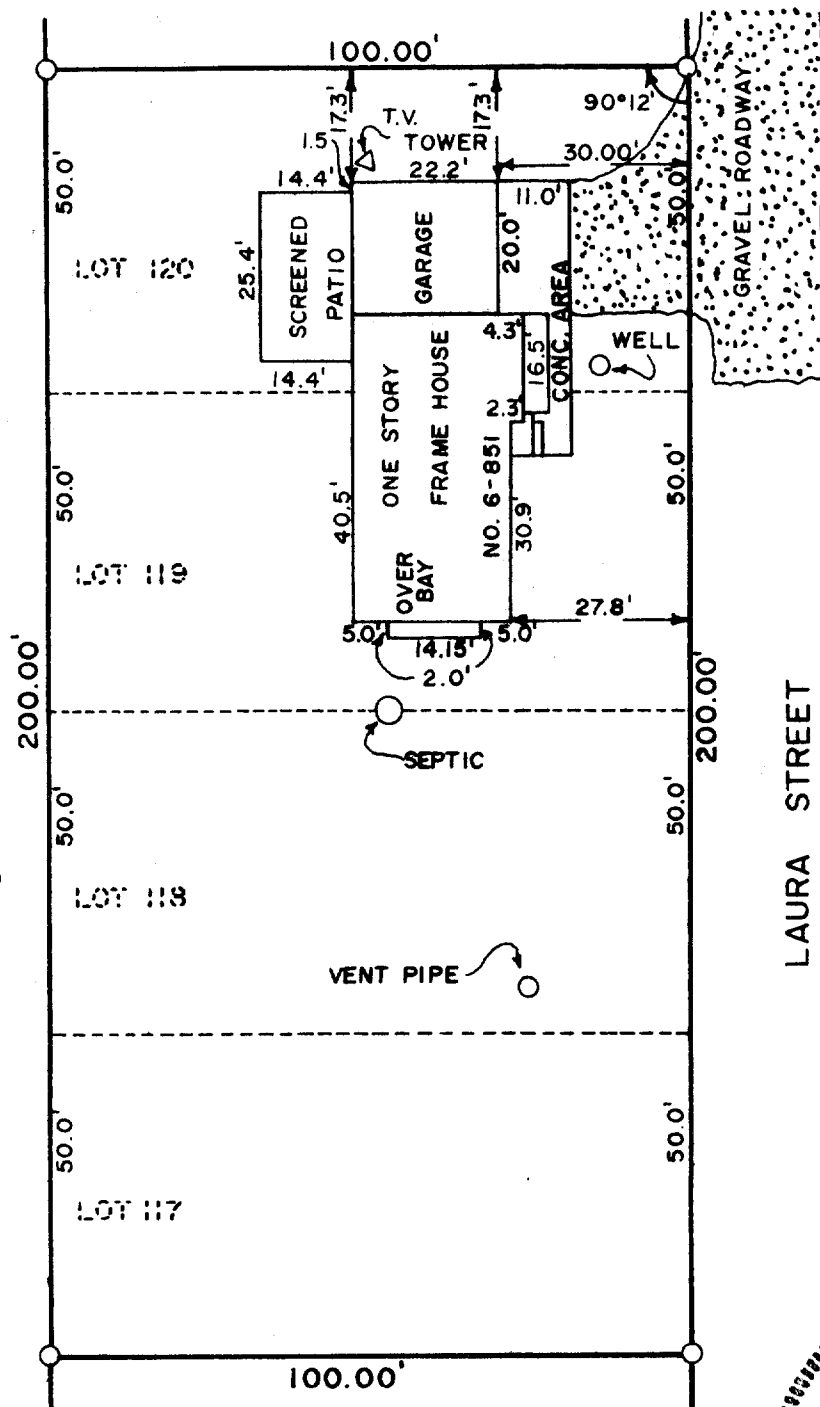

LAURA STREET
(34' R/W) UNIMPROVED



SURVEYOR'S CERTIFICATE

I HEREBY CERTIFY THAT I HAVE SURVEYED THE ABOVE DESCRIBED PROPERTY AND THE ABOVE MAP IS A TRUE REPRESENTATION THEREOF AND SHOWS THE SIZE AND LOCATION OF THE PROPERTY, ITS EXTERIOR BOUNDARIES, THE LOCATION AND DIMENSIONS OF ALL VISIBLE STRUCTURES THEREON. THIS SURVEY IS MADE FOR THE EXCLUSIVE USE OF THE PRESENT OWNERS OF THE PROPERTY, AND ALSO THOSE WHO PURCHASE, MORTGAGE, OR GUARANTEE THE TITLE THERETO WITHIN ONE (1) YEAR FROM DATE HEREOF.

DATE 8 Oct. 1984

SURVEYOR Ralph L. Anderson, R.L.S.

JOB NO. 24184
EWC

EH-666

116-186