


ABELL  
SURVEYING & MAPPING  
DELAVAN, WISCONSIN 53115  
414-728-6737

PLAT OF SURVEY OF

LOT 32 AND LOTS 40 AND  
41 OF HILLSIDE SUBDIVISION  
LOCATED IN SECTION 5,  
T1N, R16E, WALWORTH COUNTY,  
WISCONSIN.

ORDERED BY:  
CENTURY 21-SKANDIA REALTY  
312 S. 7th ST.  
DELAVAN, WI. 53115

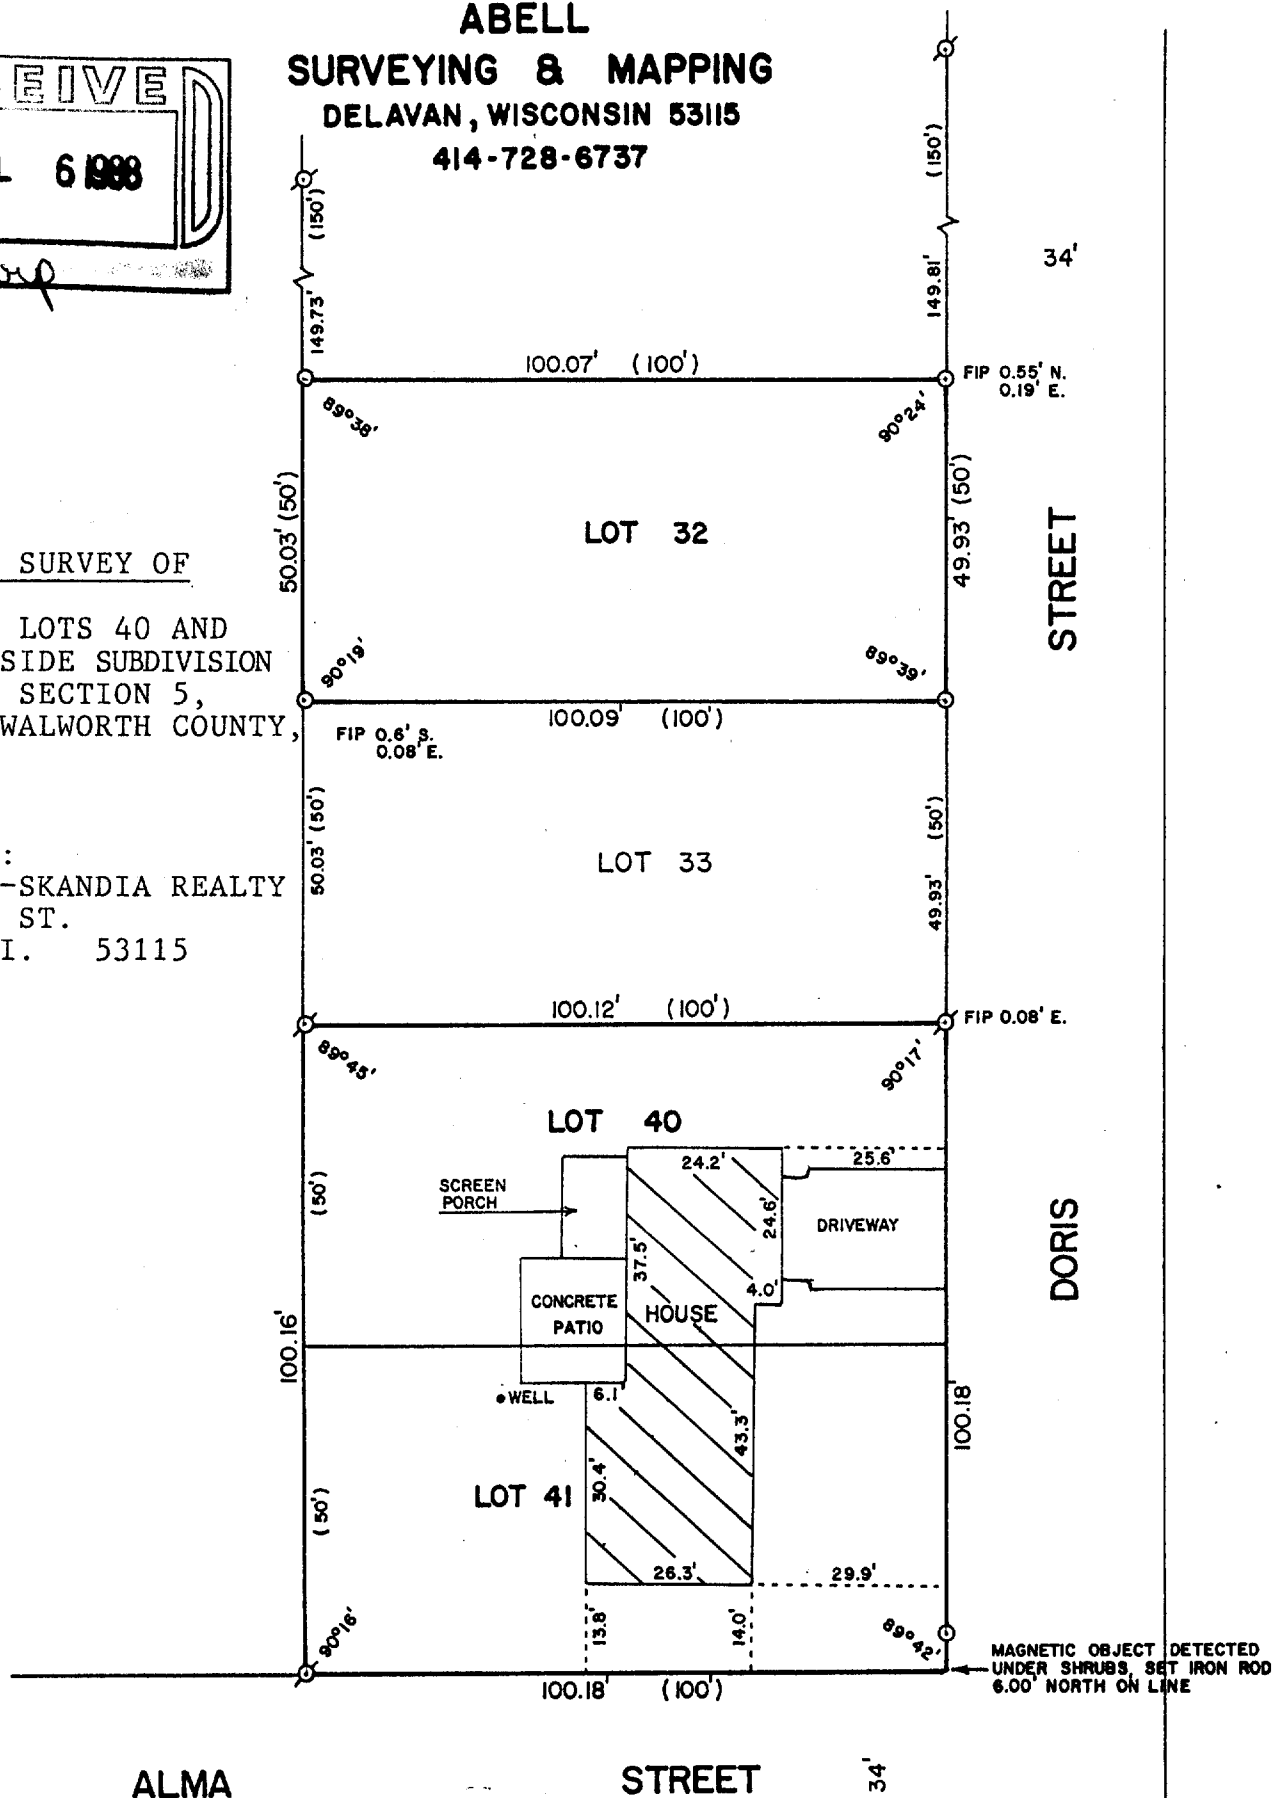

SCALE - 1"=30'

LEGEND

- ⊙ - IRON PIPE FOUND
- - IRON ROD SET
- ( ) - RECORDED AS

I, DAVID F. ABELL, DO HEREBY CERTIFY  
THAT I HAVE SURVEYED THE PROPERTY  
HEREON DESCRIBED ACCORDING TO THE  
OFFICIAL RECORDS AND THAT THE PLAT  
HEREON IS A CORRECT REPRESENTATION  
OF THE PROPERTY LINES TO THE BEST OF  
MY KNOWLEDGE AND BELIEF.

*David F. Abell*

DAVID F. ABELL  
WISCONSIN REGISTERED LAND SURVEYOR, S-1596

*March 10, 1988*

DATE JOB NUMBER - 88016  
NOTE: THIS IS NOT A CERTIFIED COPY UNLESS SEALED.