


**ABELL  
SURVEYING & MAPPING  
DELAVAN, WISCONSIN 53115  
414-720-6757**

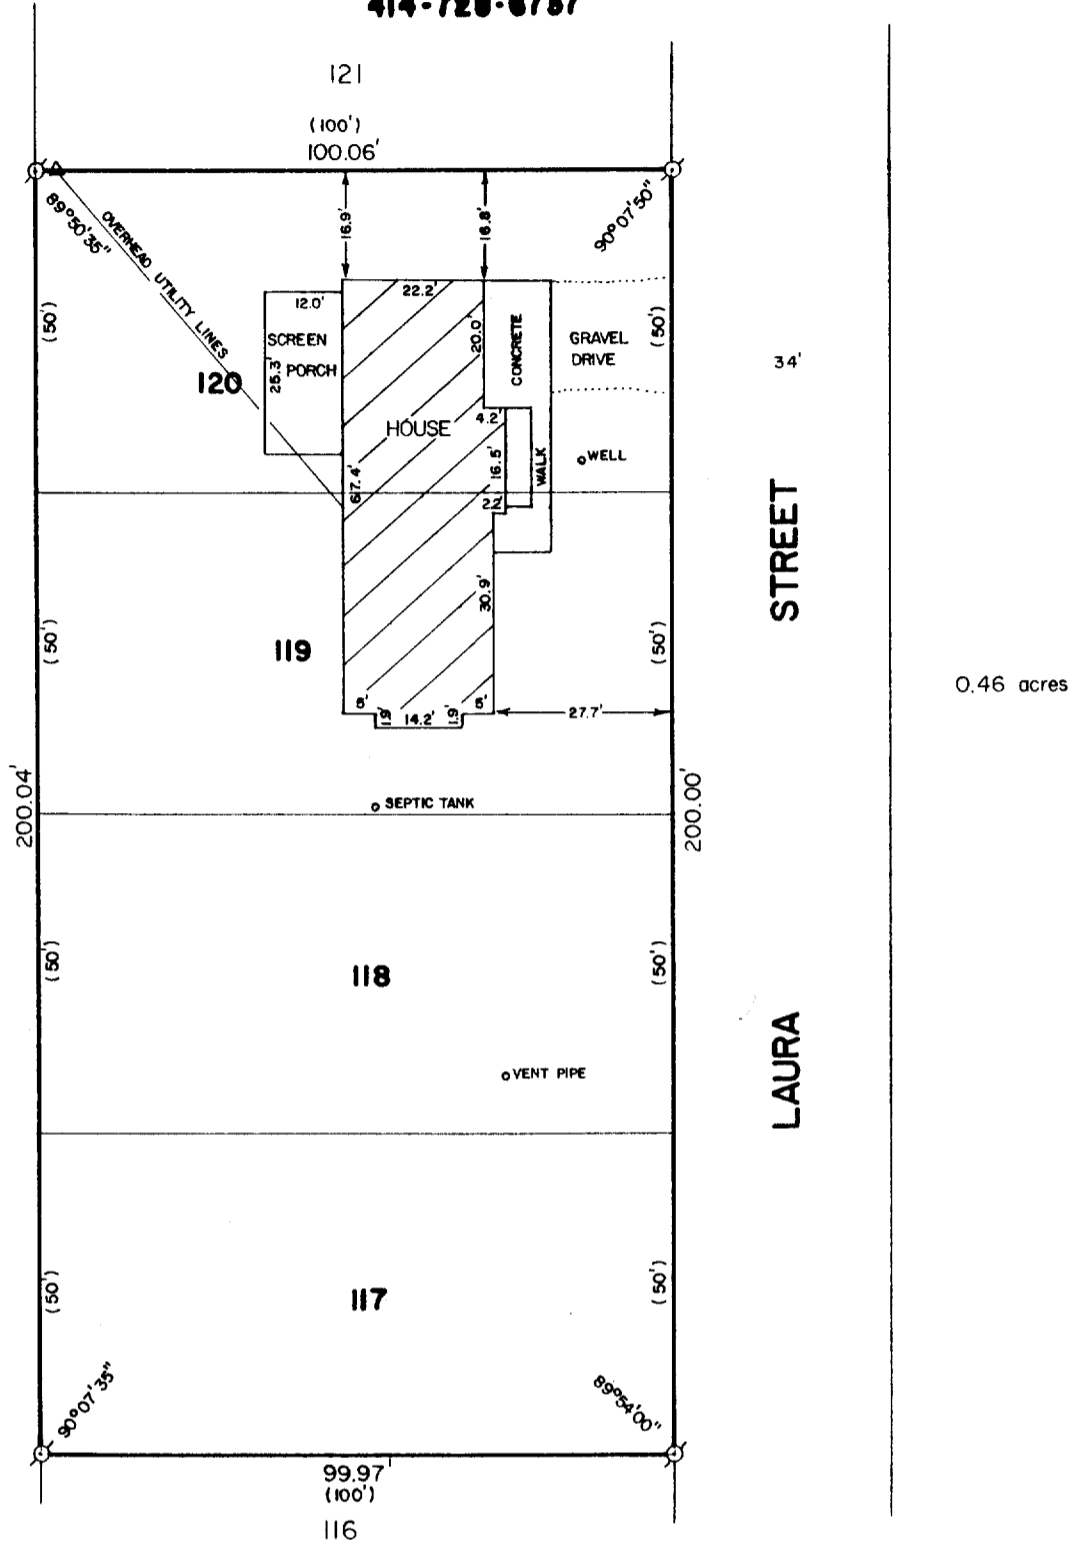

**RECEIVED**  
JAN 18 1990

**PLAT OF SURVEY OF**

LOTS 117-120 OF HILLSIDE SUBDIVISION, LOCATED IN THE  
TOWN OF WALWORTH, T1N,R16E, WALWORTH COUNTY, WISCONSIN.

ORDERED BY: CENTURY 21 - SKANDIA REALTY  
312 S. 7th STREET  
DELAVAN, WI. 53115



SCALE - 1"=30'

**LEGEND**

- ⊙ - IRON PIPE FOUND
- ◁ - UTILITY POLE
- ( ) - RECORDED AS

I HEREBY CERTIFY THAT I HAVE SURVEYED THE ABOVE DESCRIBED PROPERTY AND THAT THE ABOVE MAP IS A TRUE REPRESENTATION THEREOF AND SHOWS THE SIZE AND LOCATION OF THE PROPERTY, ITS EXTERIOR BOUNDARIES, THE LOCATION OF ALL VISIBLE STRUCTURES AND DIMENSIONS OF ALL PRINCIPAL BUILDINGS THEREON, BOUNDARY FENCES, APPARENT EASEMENTS, ROADWAYS AND VISIBLE ENCROACHMENTS, IF ANY, TO THE BEST OF MY KNOWLEDGE AND BELIEF.

THIS SURVEY IS MADE FOR THE USE OF THE PRESENT OWNERS OF THE PROPERTY, AND ALSO THOSE WHO PURCHASE, MORTGAGE, OR GUARANTEE THE TITLE THERETO WITHIN ONE (1) YEAR FROM DATE HEREOF.

*David F. Abell*  
DAVID F. ABELL  
WISCONSIN REGISTERED LAND SURVEYOR, S-1596

*December 12, 1989*  
DATE \_\_\_\_\_ JOB NUMBER = 89263  
NOTE: THIS IS NOT A CERTIFIED COPY UNLESS SEALED.