


of

Surveyed for: Terry Schaid
P.O. Box 153
Walworth, Wisconsin. 53184

Bearings referenced to
C.S.M. 998.

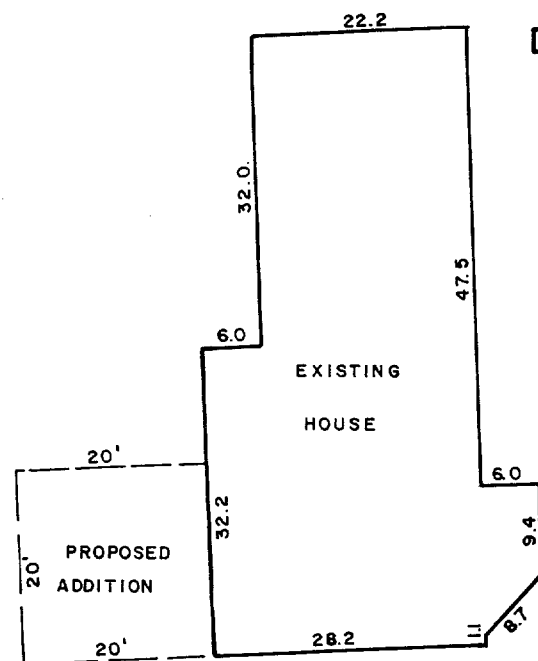

DETAIL

$$1'' = 20'$$


RECEIVED
OCT 29 1991
dg

Copyright © 1991 by Jensen Surveying & Mapping S.C.
All rights reserved. No part of this survey plat may be reproduced or transmitted in any form by any means - graphic, electronic, or mechanical, including photocopying, tracing, or information storage and retrieval systems - without permission in writing from Thomas P.A. Jensen.

I, Thomas P.A. Jensen, Wisconsin Registered Land Surveyor, do hereby certify that this survey was performed by me, or under my direction, in full compliance with the owner's/agent's instructions and Chapter A-E 7 of the Wisconsin Administrative Code ' Minimum Standards For Property Surveys ', and that this map is an accurate representation thereof to the best of my knowledge and belief.

Note: This survey plat is not certified unless signed and sealed in red ink.


Thomas P.A. Jensen R.L.S. 1084

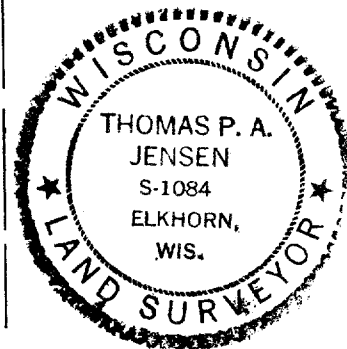

Legend

- Found iron pipe
- Set iron pipe
- () Recorded as dimension
- Well
- Septic vent

Jensen Surveying & Mapping S.C.

Mapping date: July 1, 1991

Revisions:

45 South Wisconsin Street P.O. Box 322

Elkhorn, Wisconsin. 53121.

(414) 723-3434

Sheet 1 of 1 Sheets

Job reference number:

Scale: 1 = 100'

116-304