
ABELL SURVEYING & MAPPING

DELAVAN. WISCONSIN 53115 414-728-6737



PLAT OF SURVEY OF

LOT 3. SUNSET RIDGE - UNIT 1. LOCATED IN SECTION II. TIN. RIGE. WALWORTH COUNTY, WISCONSIN.

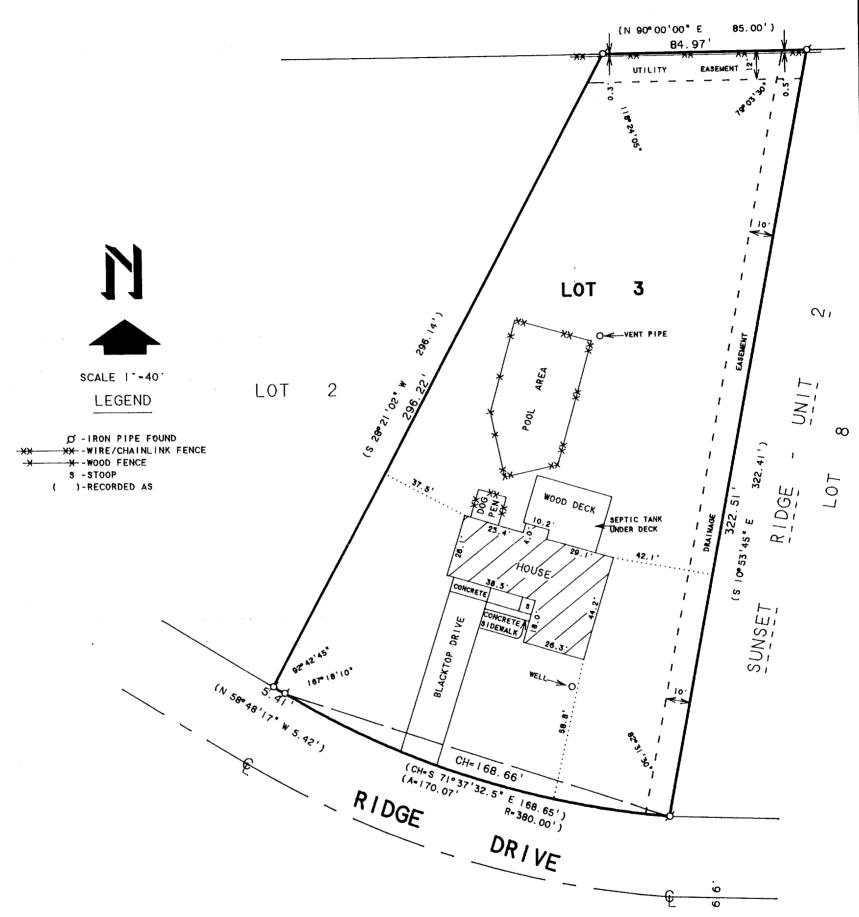

ÖRDERED BY: THE RAULAND AGENCY WALWORTH, WI. 53184 1 HEREBY CERTIFY THAT I HAVE SURVEYED THE ABOVE DESCRIBED PROPERTY AND THAT THE ABOVE MAP IS A TRUE REPRESENTATION THEREOF AND SHOWS THE SIZE AND LOCATION OF THE PROPERTY. ITS EXTERIOR BOUNDARIES. THE LOCATION OF ALL VISIBLE STRUCTURES AND DIMENSIONS OF ALL PRINCIPAL BUILDINGS THEREON. BOUNDARY FENCES. APPARENT EASEMENTS. ROADWAYS AND VISIBLE ENCROACHMENTS. IF ANY. TO THE BEST OF MY KNOWLEDGE AND BELIEF.

THIS SURVEY IS MADE FOR THE USE OF THE PRESENT OWNERS OF THE PROPERTY. AND ALSO THOSE WHO PURCHASE. MORTGAGE. OR GUARANTEE THE TITLE THERETO WITHIN ONE (I) YEAR FROM THE HEREON.

DAVID F. ABELL WISCONSIN REGISTERED LAND SURVEYOR. S-1596

March 24, 1992

DATE JOB NUMBER - 92045 NOTE: THIS IS NOT A CERTIFIED CORY UNLESS SEALED,