


KOLB LAND CONSULTING, INC.
LAND SURVEYING • SUBDIVIDING • LAND PLANNING

LAKE GENEVA, WISCONSIN 53147

414-248-3697


ORDERED BY: MICHEAL SHERIN
RT. 5 BOX 411
DELAVER, WI. 53115

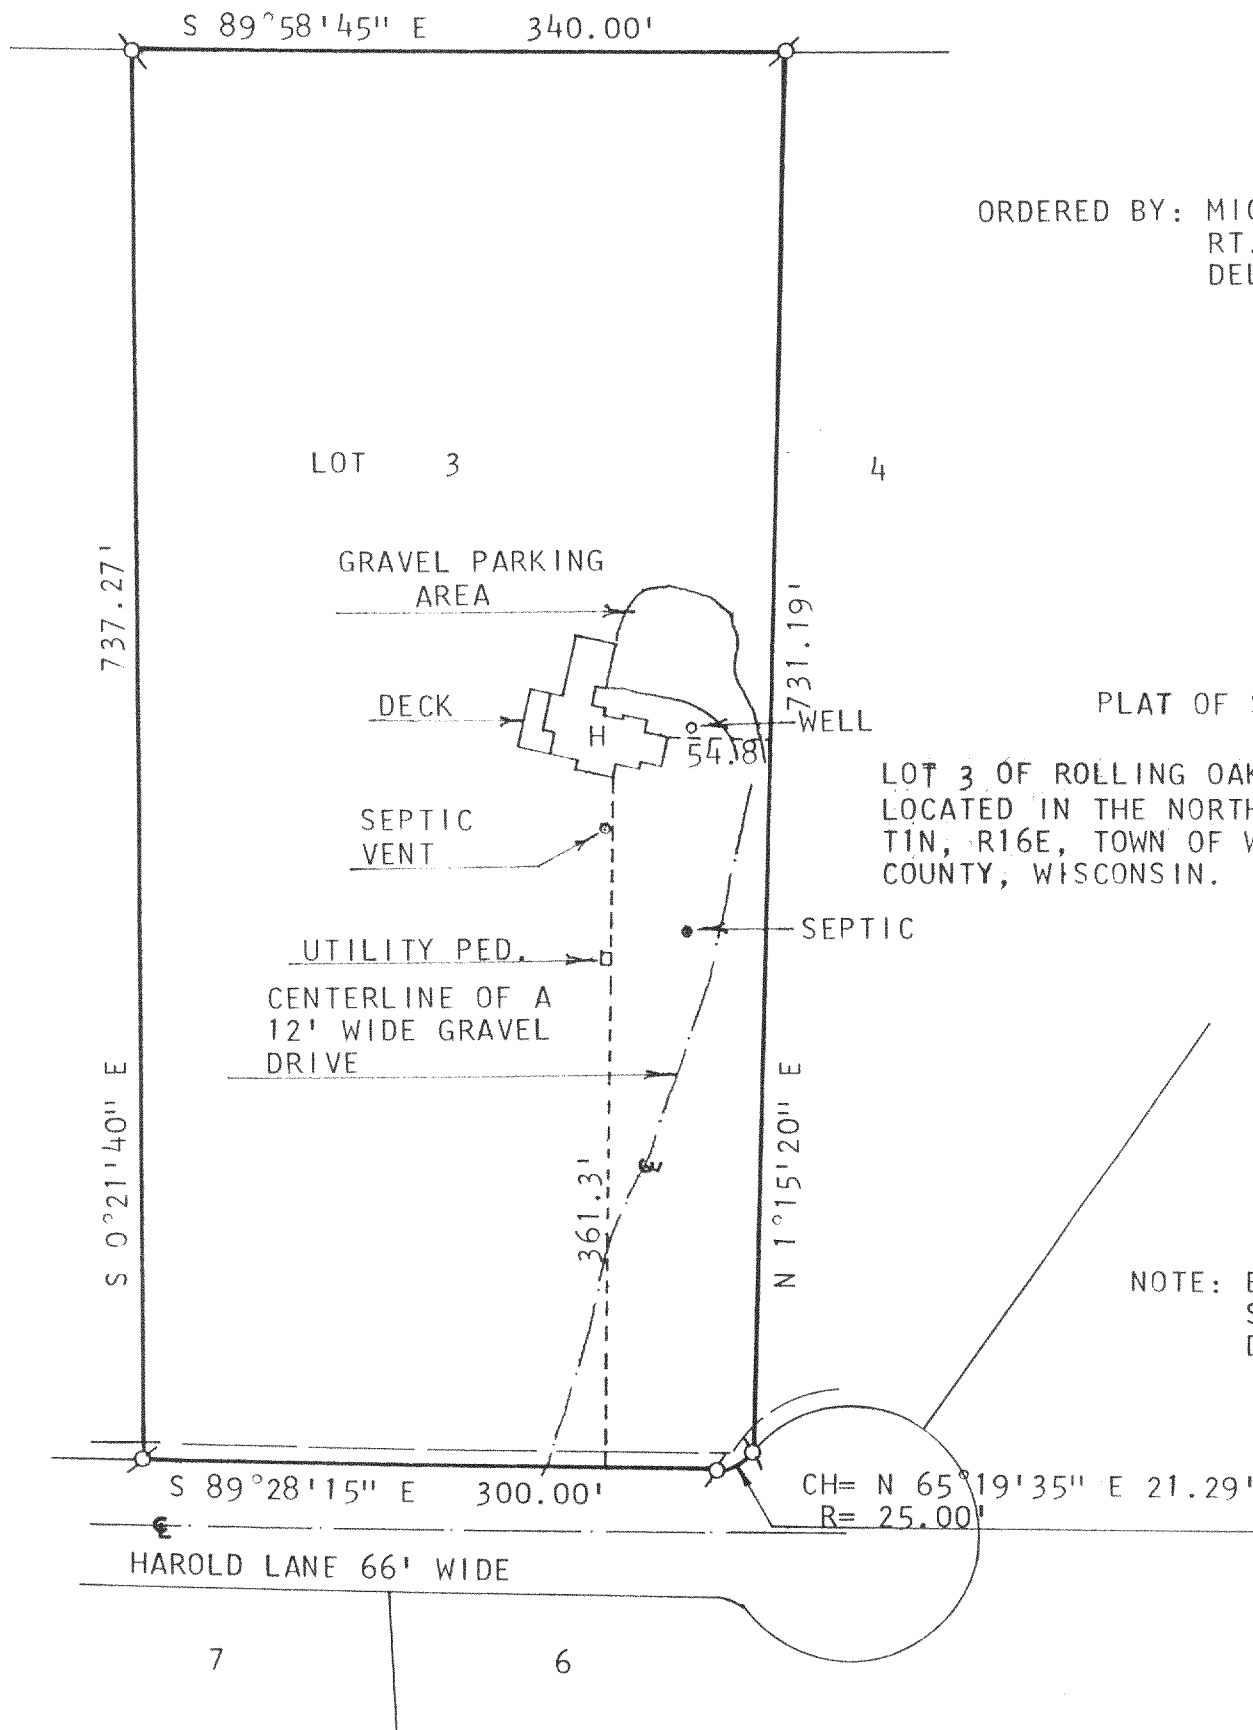

PLAT OF SURVEY OF

LOT 3 OF ROLLING OAKS ESTATE A SUBDIVISION
LOCATED IN THE NORTHEAST 1/4 OF SECTION 7,
T1N, R16E, TOWN OF WALWORTH, WALWORTH
COUNTY, WISCONSIN.

NOTE: BEARINGS ARE ASSUMED AS
SHOWN ON RECORDED SUB-
DIVISION PLAT.

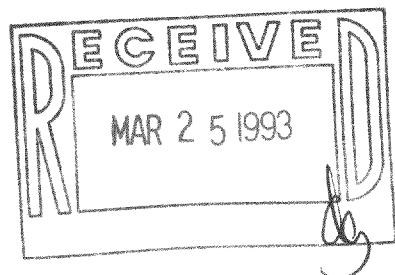

SCALE: 1" = 100'
LEGEND
ø - IRON PIPE FOUND
H - HOUSE

I HEREBY CERTIFY THAT I HAVE SURVEYED THE
ABOVE DESCRIBED PROPERTY AND THAT THE
ABOVE MAP IS A TRUE REPRESENTATION THERE-
OF AND SHOWS THE SIZE AND LOCATION OF THE
PROPERTY, ITS EXTERIOR BOUNDARIES, THE
LOCATION OF ALL VISIBLE STRUCTURES AND
DIMENSIONS OF ALL PRINCIPAL BUILDINGS
THEREON, BOUNDARY FENCES, APPARENT
EASEMENTS, ROADWAYS AND VISIBLE ENCROACH-
MENTS, IF ANY, TO THE BEST OF MY KNOW-
LEDGE AND BELIEF.
THIS SURVEY IS MADE FOR THE USE OF THE
PRESENT OWNERS OF THE PROPERTY AND ALSO
THOSE WHO PURCHASE, MORTGAGE OR GUAR-
ANTEE THE TITLE THERETO WITHIN ONE (1)
YEAR FROM DATE HEREOF.

HAROLD H. KOLB
WISCONSIN REGISTERED LAND SURVEYOR, S-187
DATE NOVEMBER 10, 1992


ERO-3

116-370

KOLB LAND CONSULTING, INC.
LAND SURVEYING • SUBDIVIDING • LAND PLANNING

LAKE GENEVA, WISCONSIN 53147

414-248-3697

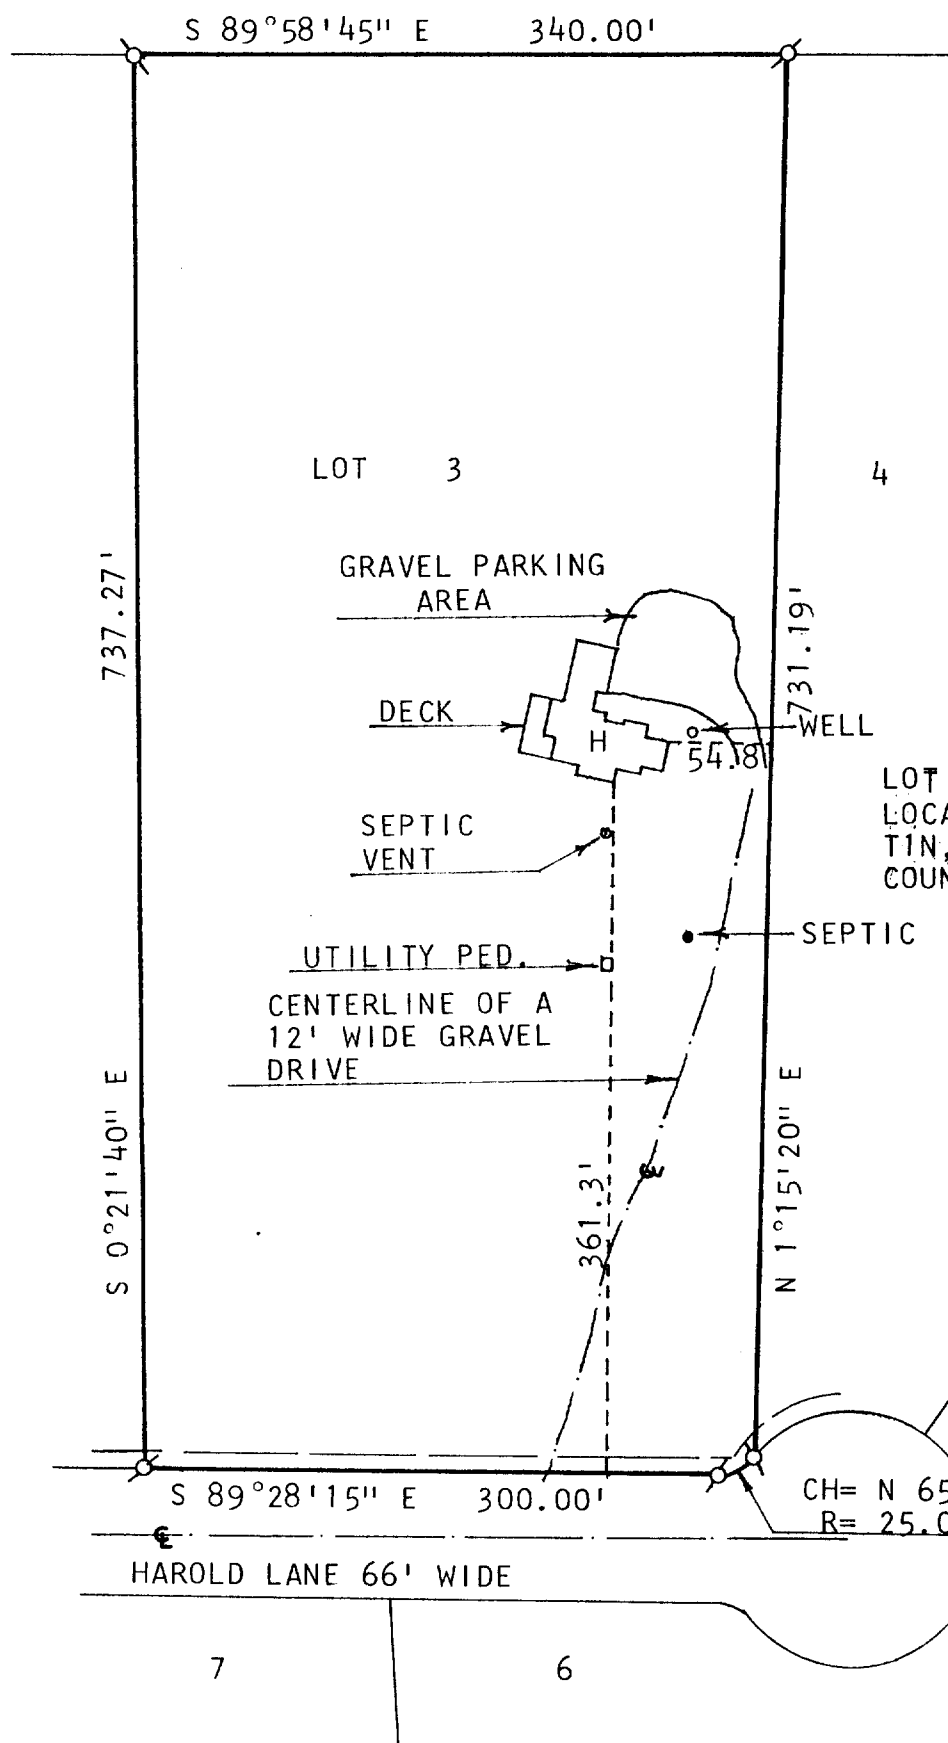


ORDERED BY: MICHEAL SHERIN
RT. 5 BOX 411
DELAVER, WI. 53115

PLAT OF SURVEY OF

LOT 3 OF ROLLING OAKS ESTATE A SUBDIVISION
LOCATED IN THE NORTHEAST 1/4 OF SECTION 7,
T1N, R16E, TOWN OF WALWORTH, WALWORTH
COUNTY, WISCONSIN.

NOTE: BEARINGS ARE ASSUMED AS
SHOWN ON RECORDED SUB-
DIVISION PLAT.

SCALE: 1" = 100'
LEGEND
Ø - IRON PIPE FOUND
H - HOUSE

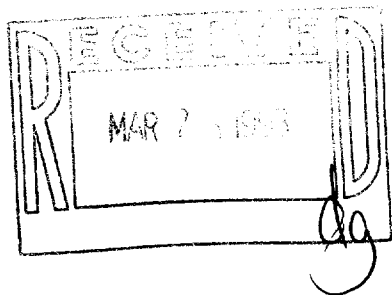

I HEREBY CERTIFY THAT I HAVE SURVEYED THE
ABOVE DESCRIBED PROPERTY AND THAT THE
ABOVE MAP IS A TRUE REPRESENTATION THERE-
OF AND SHOWS THE SIZE AND LOCATION OF THE
PROPERTY, ITS EXTERIOR BOUNDARIES, THE
LOCATION OF ALL VISIBLE STRUCTURES AND
DIMENSIONS OF ALL PRINCIPAL BUILDINGS
THEREON, BOUNDARY FENCES, APPARENT
EASEMENTS, ROADWAYS AND VISIBLE ENCROACH-
MENTS, IF ANY, TO THE BEST OF MY KNOW-
LEDGE AND BELIEF.
THIS SURVEY IS MADE FOR THE USE OF THE
PRESENT OWNERS OF THE PROPERTY AND ALSO
THOSE WHO PURCHASE, MORTGAGE OR GUAR-
ANTEE THE TITLE THERETO WITHIN ONE (1)
YEAR FROM DATE HEREOF.

HAROLD H. KOLB
WISCONSIN REGISTERED LAND SURVEYOR, S-187
DATE NOVEMBER 6, 1992

ERO-3

116-370