


DUNHAM SURVEYING, S.C.
SURVEYING & SUBDIVIDING
DELAVER, WISCONSIN 53115

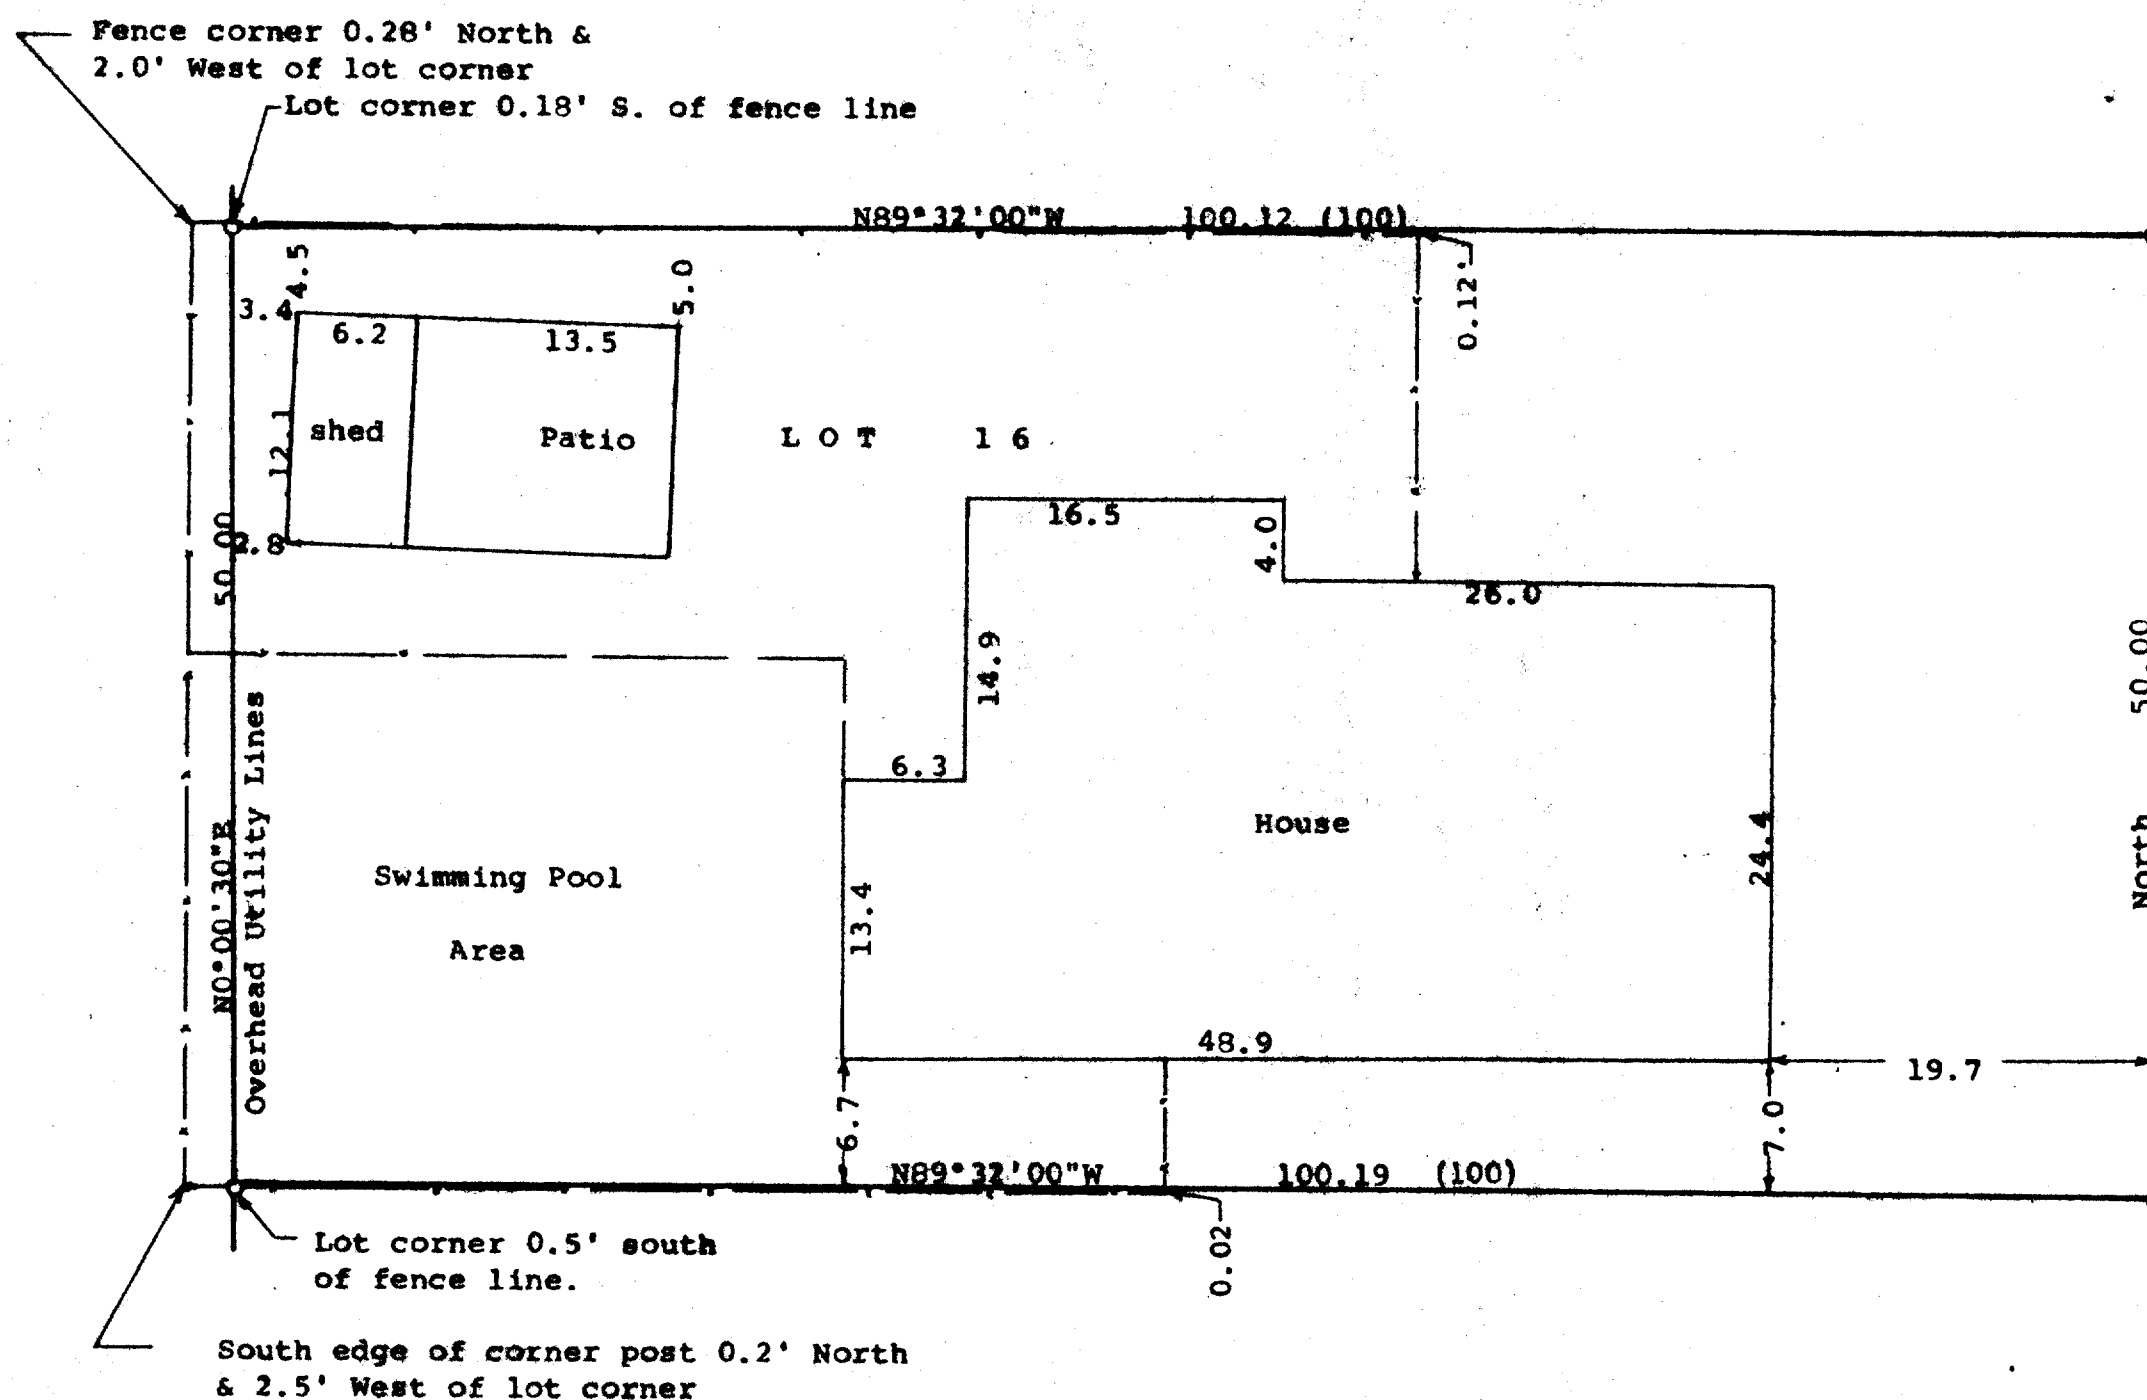

STREET


DORIS

N

STATE OF WISCONSIN)
COUNTY OF WALWORTH) SS

I, George T. Dunham, Surveyor, certify that I have surveyed the property described as follows:
Lot 16 of Hillside Subdivision located in Section 5, T 1 N, R 16 E, Walworth County, Wisconsin,
and that the plat shown hereon is a correct representation thereof and shows the size and location of the property, its exterior boundaries, the location of all visible structures and dimensions of all principal buildings thereon, boundary fences, apparent easements, roadways and visible encroachments, if any, and that I have surveyed the property hereon described, according to the official records, to the best of my knowledge and belief.
April 21, 1993

George T. Dunham
George T. Dunham, Surveyor

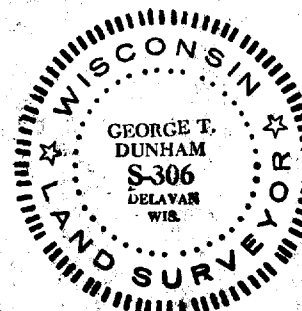

Scale - 1" = 10'
O = 3/4" Iron Pipe Found
--- = Fence Line

Bearings referenced to the west line of Doris Street with the assumed bearing of North

Survey ordered by: Century 21,
Skandia Realty
312 South 7th Street
Delavan, WI 53115

(0.00) = recorded distance

