
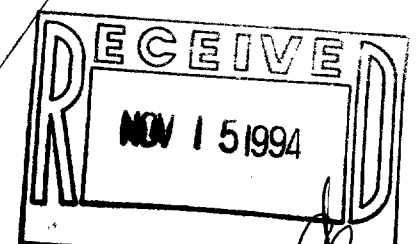


PLAT OF SURVEY

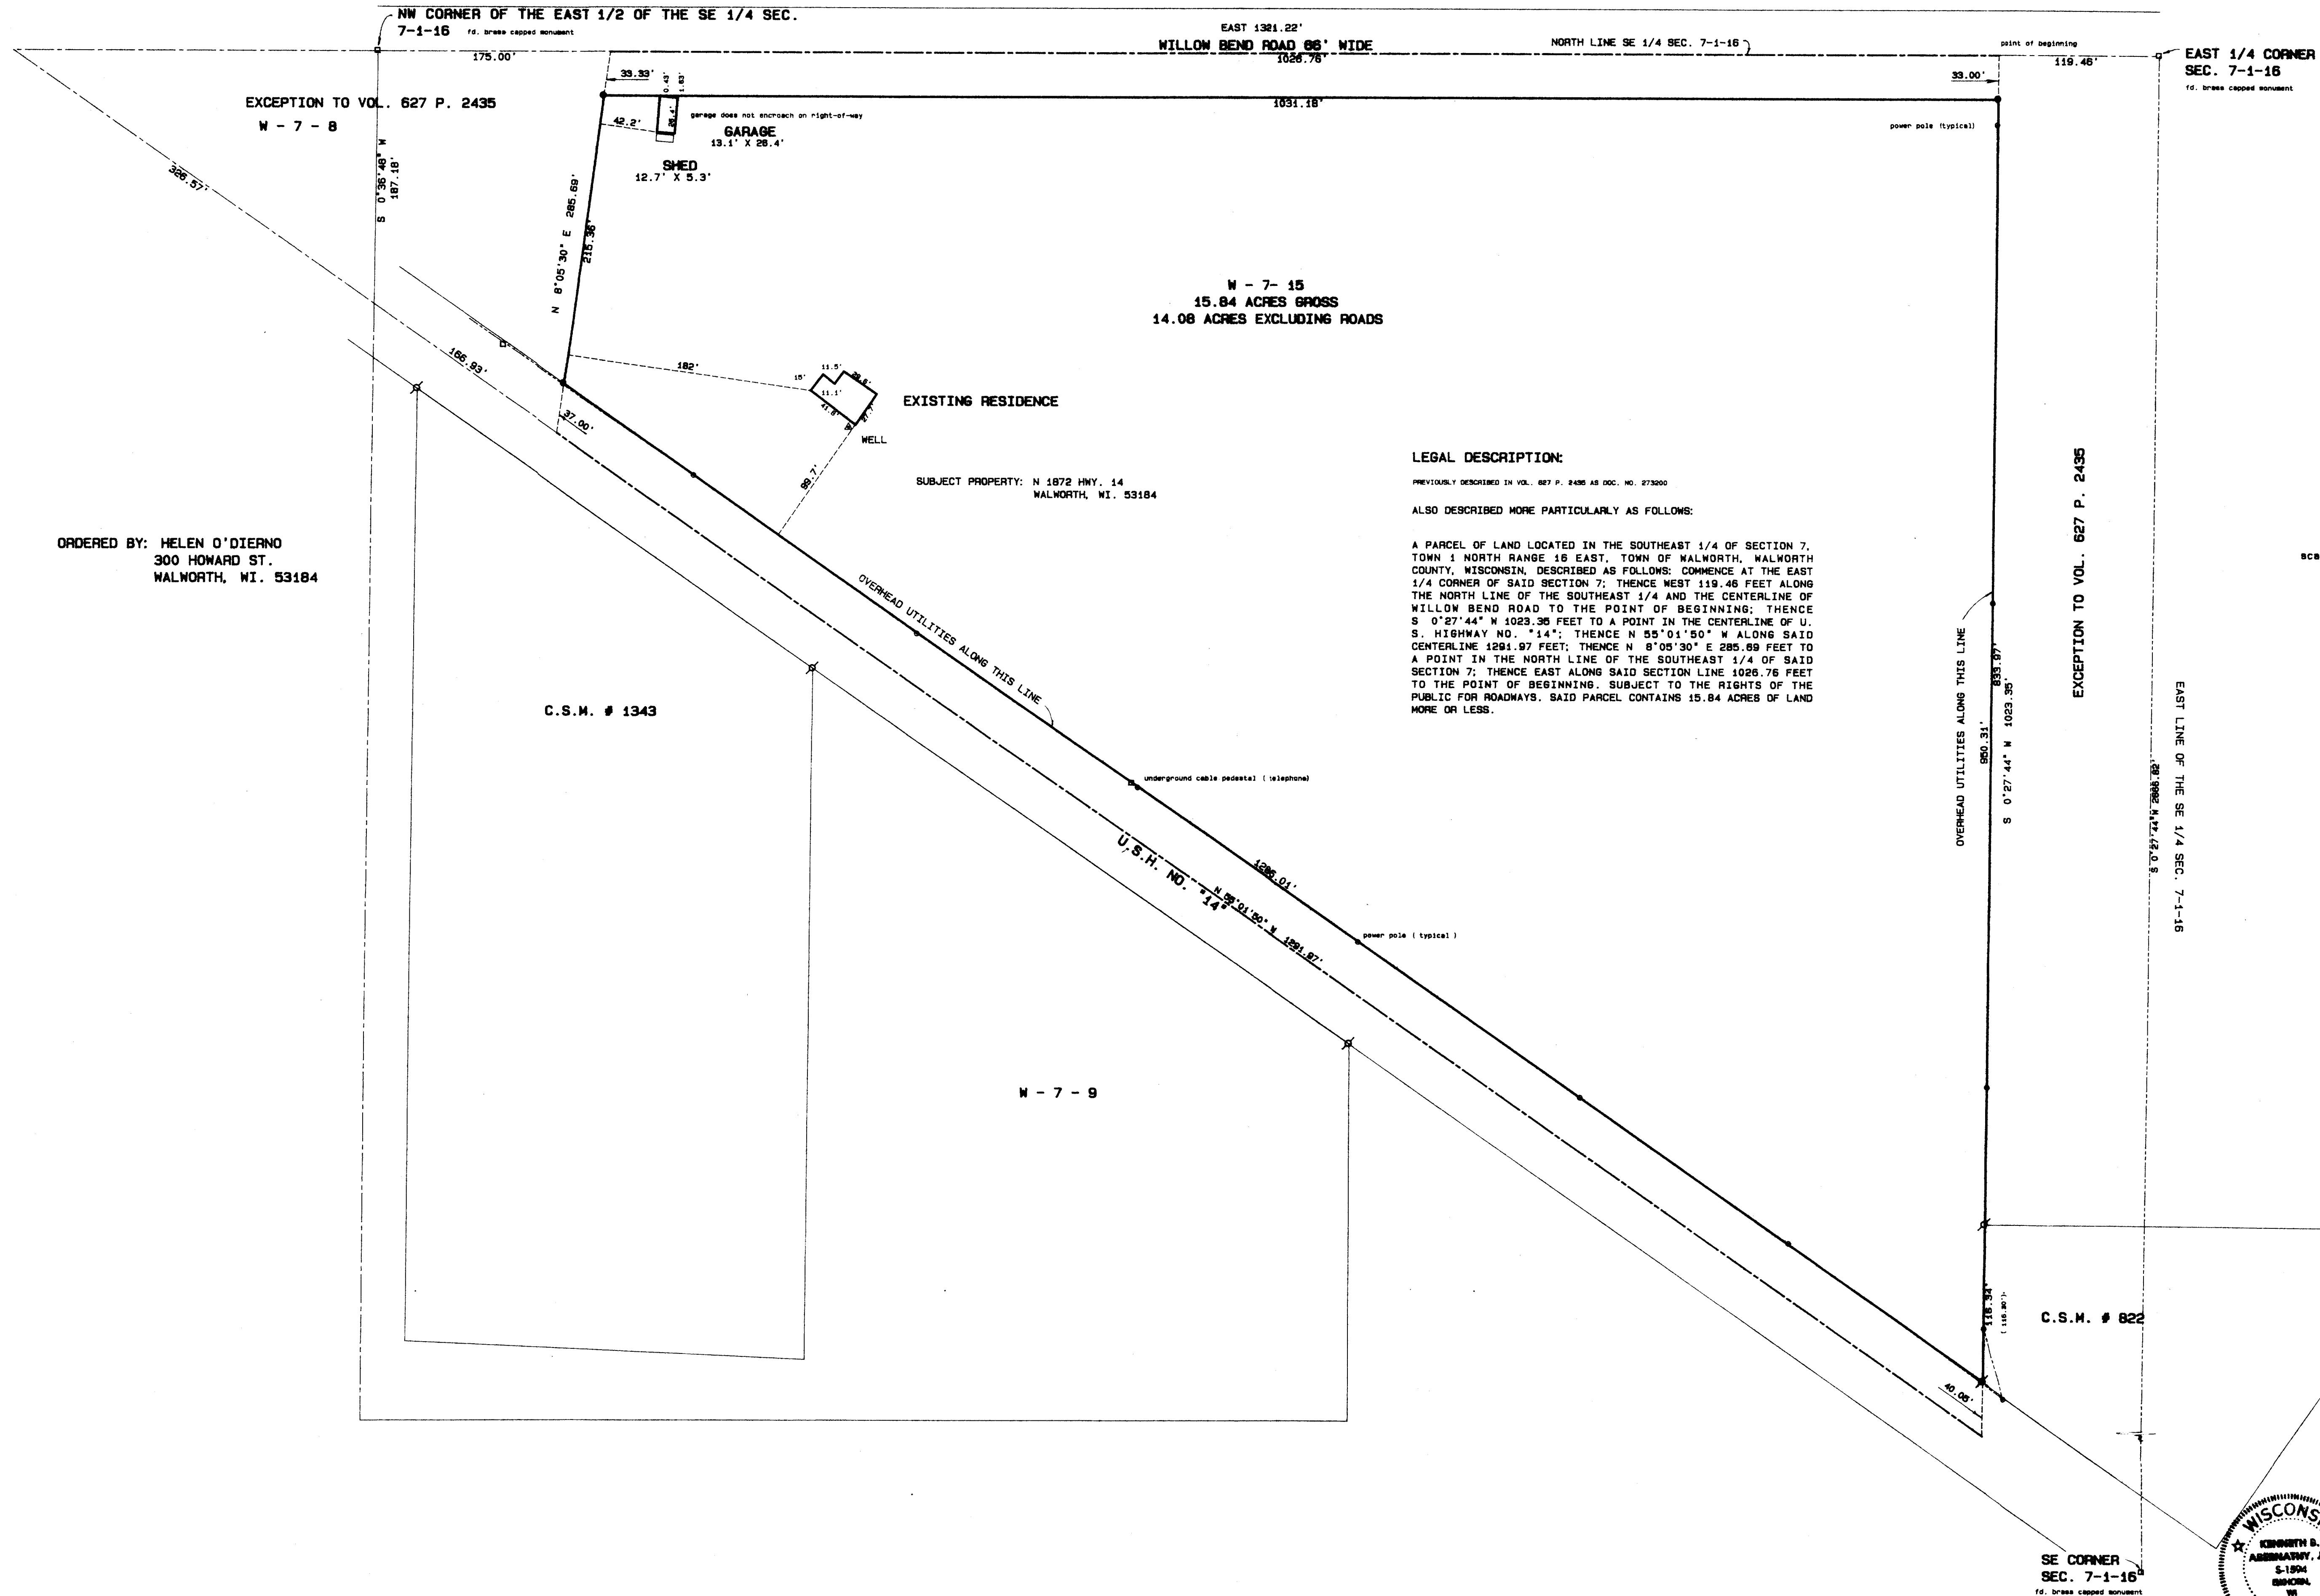

Kenneth B. Abernathy, Jr.
WISCONSIN REGISTERED LAND SURVEYOR
S-1594
Date: 7-27-94 Job No. 94-718