


116-439

**ABELL
SURVEYING & MAPPING
DELAVER, WISCONSIN 53115
414-728-6737**



N

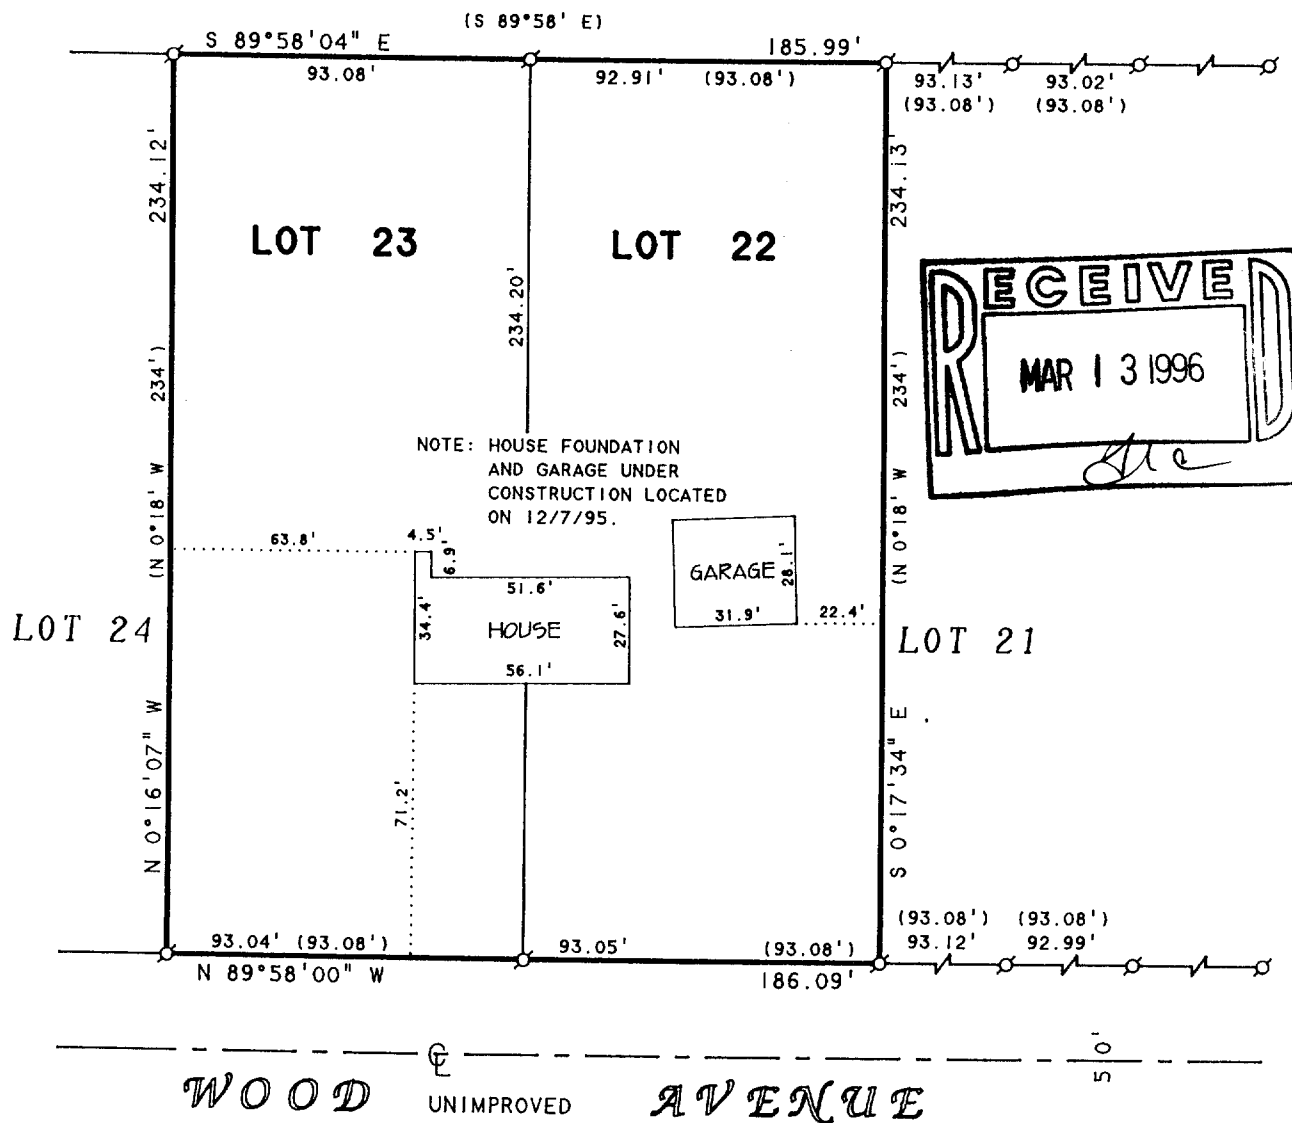

SCALE 1"=50'

LEGEND

⊙ -IRON PIPE FOUND
() -RECORDED AS

NOTE: BEARINGS ARE REFERENCED TO THE
RECORDED SUBDIVISION PLAT.

PLAT OF SURVEY OF

LOTS 22 AND 23, ADDITION NO. 1
TO ROBBINS SUBDIVISION, LOCATED
IN T1N, R16E, WALWORTH COUNTY,
WISCONSIN.

I HEREBY CERTIFY THAT I HAVE SURVEYED THE ABOVE DESCRIBED PROPERTY AND THAT THE ABOVE MAP IS A TRUE REPRESENTATION THEREOF AND SHOWS THE SIZE AND LOCATION OF THE PROPERTY, ITS EXTERIOR BOUNDARIES, THE LOCATION OF ALL VISIBLE STRUCTURES AND DIMENSIONS OF ALL PRINCIPAL BUILDINGS THEREON, BOUNDARY FENCES, APPARENT EASEMENTS, ROADWAYS AND VISIBLE ENCROACHMENTS, IF ANY, TO THE BEST OF MY KNOWLEDGE AND BELIEF.

THIS SURVEY IS MADE FOR THE USE OF THE PRESENT OWNERS OF THE PROPERTY, AND ALSO THOSE WHO PURCHASE, MORTGAGE, OR GUARANTEE THE TITLE THERETO WITHIN ONE (1) YEAR FROM DATE HEREON.

David F. Abell

DAVID F. ABELL
WISCONSIN REGISTERED LAND SURVEYOR, S-1596

ORDERED BY: GORDY LOEPKE
410 N. TERRACE
APT. 8
DELAVER, WI. 53115

ERA-22

September 29, 1995

REVISED DATE: 12/7/95

DATE: JOB NUMBER - 92011
NOTE: THIS IS NOT A CERTIFIED COPY UNLESS SEALED.

116-439