


**ABELL  
SURVEYING & MAPPING**  
1140 SEQUOIA STREET  
DELAVAN, WISCONSIN  
414-728-6737

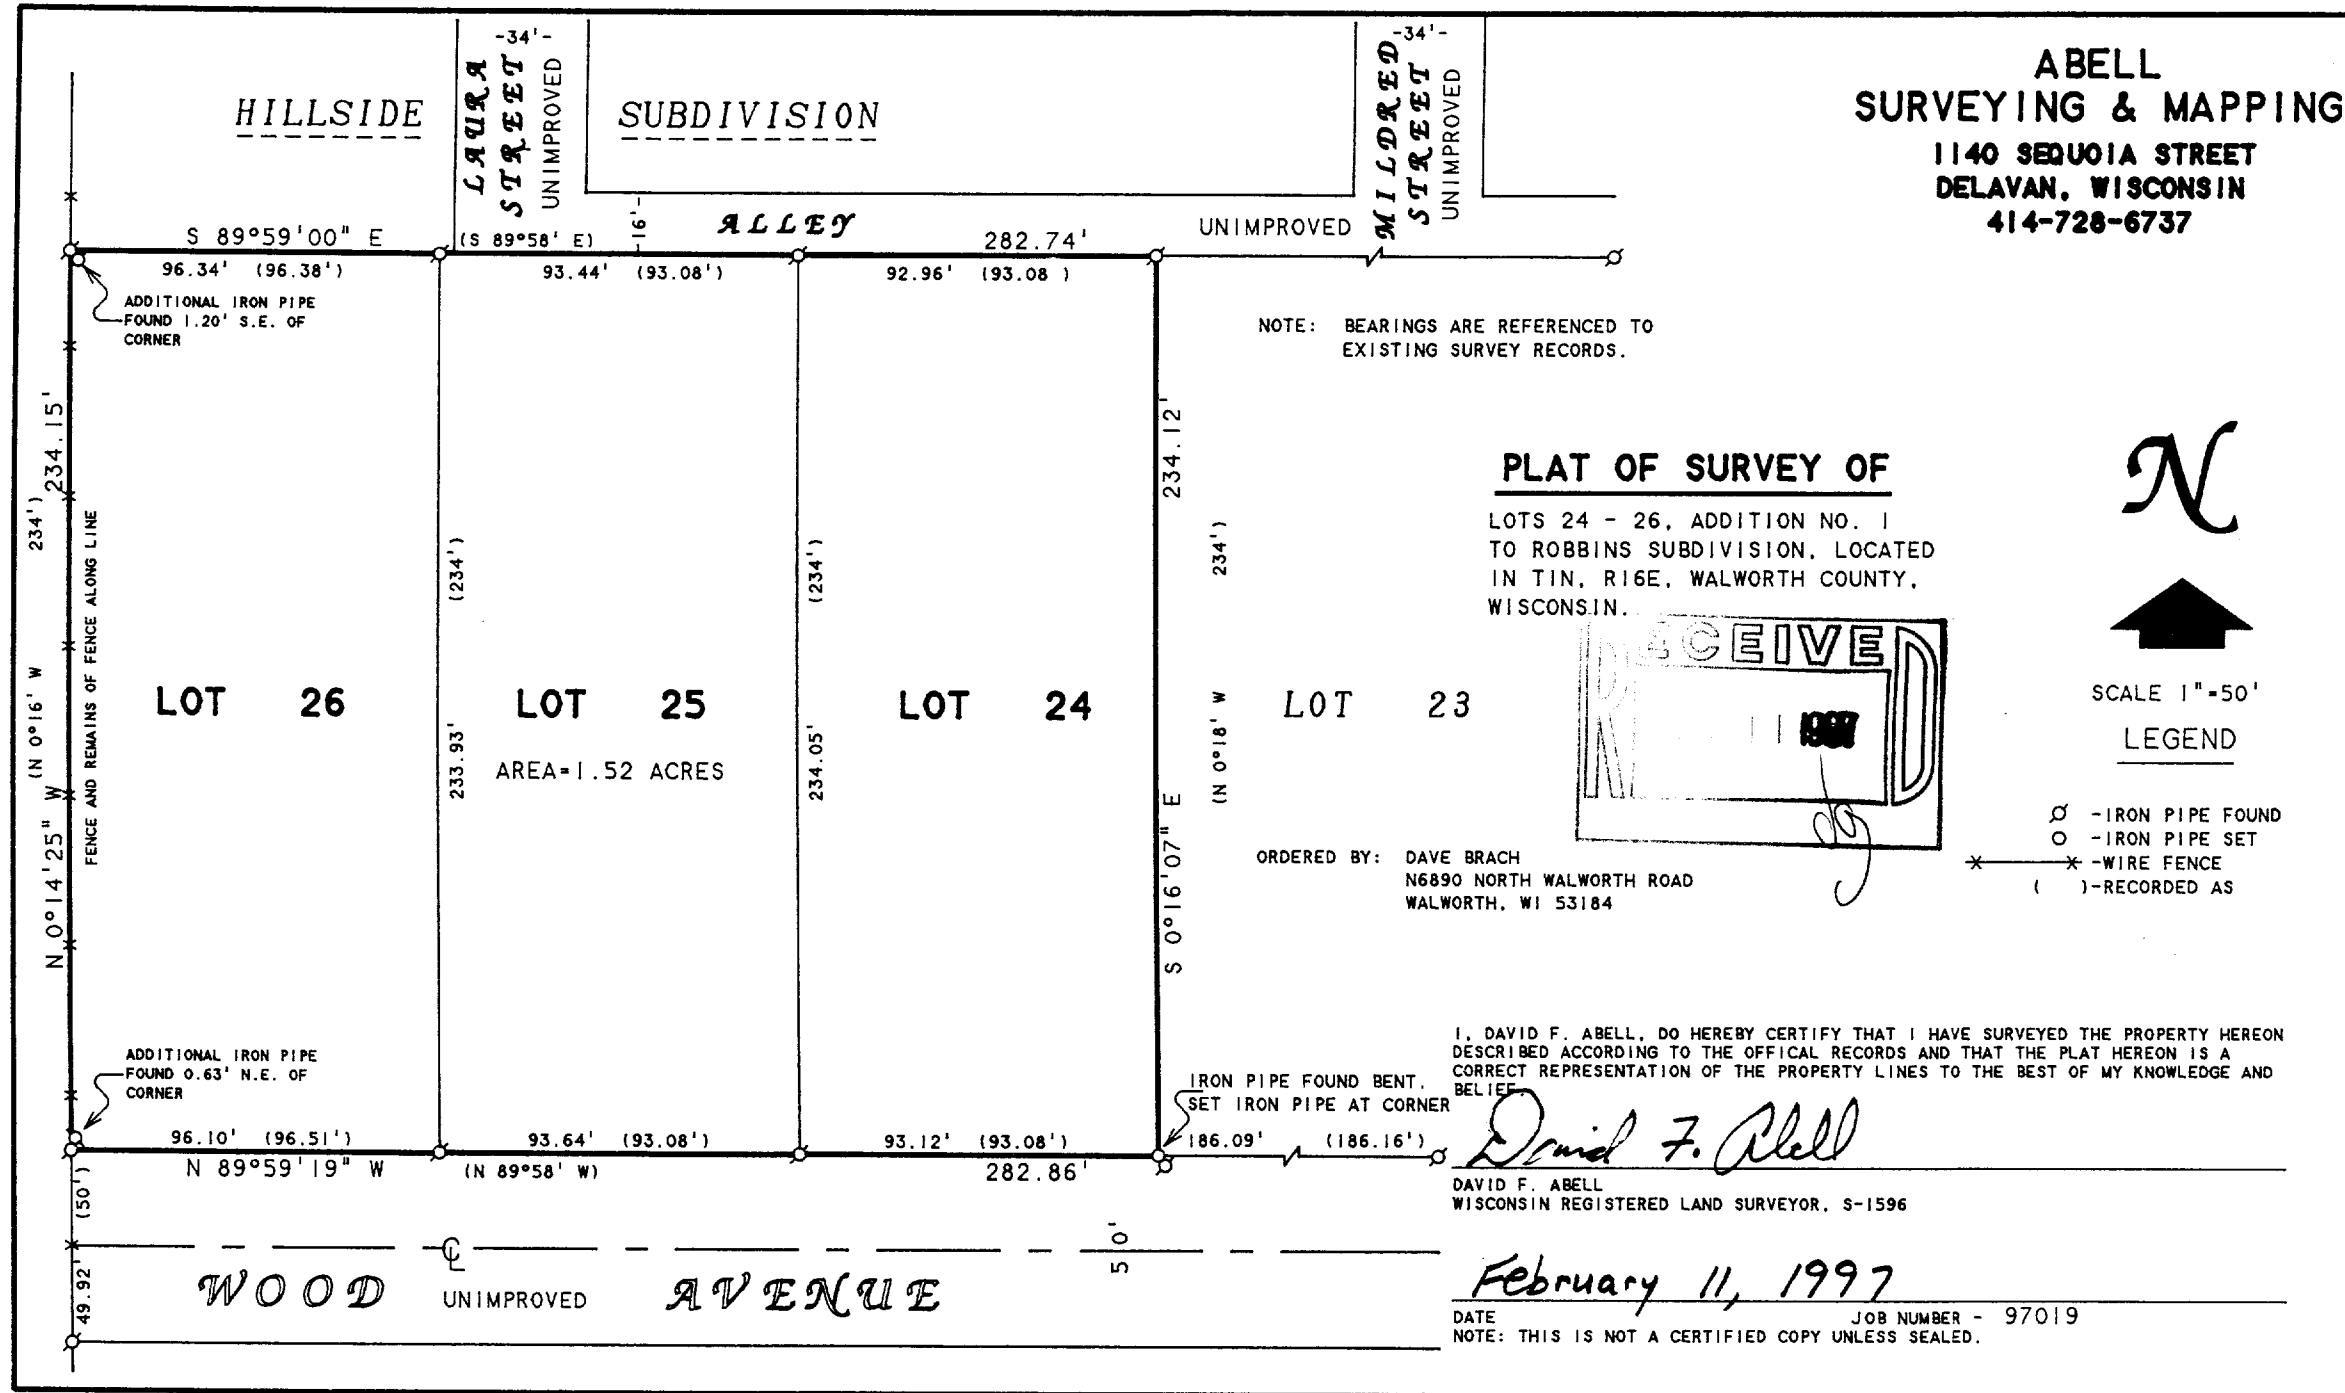

ERA-24  
ERA-25  
ERA-26

116-466