
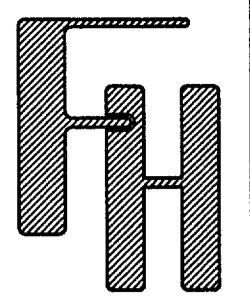


PLAT OF SURVEY  
LOT 12 OF DEER PATH ESTATES  
LOCATED IN THE SE & SW 1/4'S OF THE SE 1/4  
OF SECTION 6, TOWN 1 NORTH, RANGE 16 EAST,  
TOWN OF WALWORTH, WALWORTH COUNTY, WISCONSIN

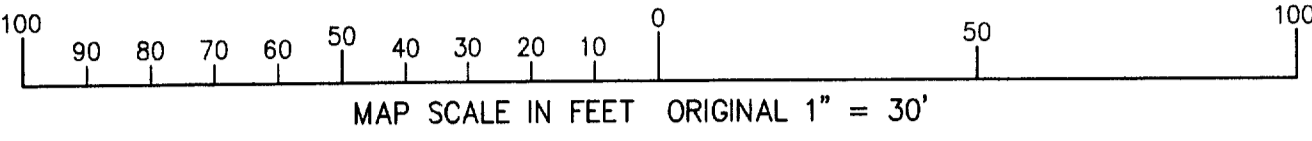

LOT 12 OF DEER PATH ESTATES  
TOWN OF WALWORTH  
WALWORTH COUNTY, WISCONSIN

WORK ORDERED BY -  
BERNARD KAUFMANN  
C/O ELKHORN ASSOCIATES  
FONTANA, WI. 53125

FARRIS, HANSEN & ASSOCIATES, INC.  
Engineering, Architecture, Surveying  
7 Ridgway Court P.O. Box 437  
ELKHORN, WISCONSIN 53121  
Office: (414) 723-2098  
Fax: (414) 723-5886

REVISIONS

PROJECT NO.  
4633.12  
DATE  
11/02/98  
SHEET NO.  
1 OF 1

FOUND IRON PIPE STAKE  
N 85-23 W, 3.7' FROM  
RECORD CORNER

16.5' WIDE  
UTILITY  
EASEMENT

LANDSCAPE  
AND VISION  
CORNER  
EASEMENT

LIMITED BUILDING  
AREA

12' WIDE  
UTILITY  
EASEMENT

LOT 12  
287,292 S.F.

N 89-24-01 E 152.89'

STORM  
WATER  
MANAGEMENT  
EASEMENT

SEPTIC  
TANK

WELL

10' UTILITY  
EASEMENT

EXTG.  
GRAVEL  
ENTRY

EXISTING ROW  
OF PINES

SAVANNAH  
66' WIDE ROW  
LANE

R = 508.00  
A = 385.44  
C = 376.26  
N 68-38-58.5 W

R = 867.00  
A = 492.37  
C = 458.91  
N 82-11-28.0 W

NOTE: COPIES OF THIS MAP TO WHICH THE FOLLOWING CERTIFICATE WILL APPLY SHOW SURVEYOR'S  
ORIGINAL SEAL AND SIGNATURE IN RED INK. COPIES BY ANY OTHER MEANS MAY HAVE ALTERATIONS  
WHICH DO NOT REPRESENT THE SURVEYOR'S WORK PRODUCT.

I HEREBY CERTIFY THAT THE ABOVE DESCRIBED PROPERTY HAS BEEN SURVEYED UNDER MY DIRECTION  
AND THAT THE ABOVE MAP IS A TRUE REPRESENTATION THEREOF AND SHOWS THE SIZE AND LOCATION OF  
THE PROPERTY AND ITS EXTERIOR BOUNDARIES. THIS SURVEY IS MADE FOR THE USE OF THE PRESENT  
OWNERS OF THE PROPERTY, AND ALSO THOSE WHO PURCHASE, MORTGAGE, OR GUARANTEE THE TITLE  
THERE TO WITHIN ONE YEAR FROM THE DATE HEREOF.

DATED: 7-6-99

PETER S. GORDON R.L.S. 2101



LEGEND

- = FOUND IRON REBAR STAKE, 3/4" DIA.
- = FOUND IRON PIPE STAKE, 1" DIA.
- = FOUND CONCRETE COUNTY  
MONUMENT W/ BRASS CAP
- = FOUND SOLID ROUND IRON BAR STAKE  
1 5/16" X 30" X 4.60 LBS./FT.

(XXX) = RECORDED AS

EDPE-12

116-526