


LOT 10

## PLAT OF SURVEY


LOT 11 OF UNIT 2 SUNSET RIDGE

LOCATED IN THE NW 1/4 OF THE NW 1/4 OF SECTION 11 TOWN 1 NORTH, RANGE 16 EAST WALWORTH COUNTY, WISCONSIN

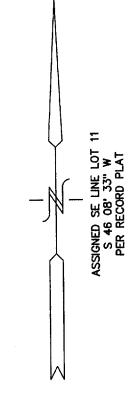

NOTE: COPIES OF THIS MAP TO WHICH THE FOLLOWING CERTIFICATE WILL APPLY ARE BLUE LINE PRINTS SHOWING SURVEYOR'S ORIGINAL SEAL AND SIGNATURE IN BLACK INK. COPIES BY ANY OTHER MEANS MAY HAVE ALTERATIONS WHICH DO NOT REPRESENT THE SURVEYOR'S

I HEREBY CERTIFY THAT THE ABOVE DESCRIBED PROPERTY HAS BEEN SURVEYED UNDER MY DIRECTION AND THAT THE ABOVE MAP IS A TRUE REPRESENTATION THEREOF AND SHOWS THE SIZE AND LOCATION OF THE PROPERTY AND ITS EXTERIOR BOUNDARIES. THIS SURVEY IS MADE FOR THE USE OF THE PRESENT OWNERS OF THE PROPERTY, AND ALSO THOSE WHO PURCHASE, MORTGAGE, OR GUARANTEE THE TITLE THERETO WITHIN ONE YEAR FROM THE DATE HEREOF.

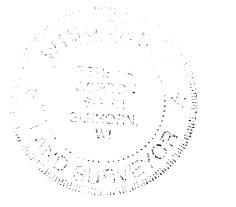

REVISIONS

PROJECT NO. 5304

06-21-99 SHEET NO. 1 OF 1

90 80 70 60 <sup>50</sup> 40 30 20 10 MAP SCALE IN FEET ORIGINAL 1" = 30'

JUN 2

UPPER & LOWER DECKS & ENCLOSED PORCH

DRAINAGE EASEMENT

LOT 12

272.14' (272.21') S 89<sup>-</sup>58'39" E (S 90'00'00" E)

12' UTILITY EASEMENT

LOT 11

1.32 AC.

60.00'

DRAINAGE EASEMENT

DRIVE