
LOCATED IN SEC.'S 22 & 23, T1N, R16E WALWORTH COUNTY, WISCONSIN

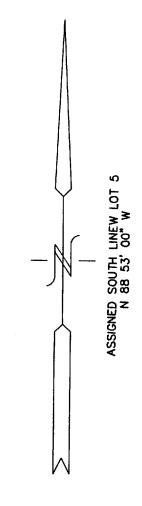

LEGEND


O = FOUND IRON PIPE STAKE 1" DIA. (xxx)= RECORDED AS


NOTE: COPIES OF THIS MAP TO WHICH THE FOLLOWING CERTIFICATE WILL APPLY SHOW SURVEYOR'S ORIGINAL SEAL AND SIGNATURE IN RED INK. COPIES BY ANY OTHER MEANS MAY HAVE ALTERATIONS WHICH DO NOT REPRESENT THE SURVEYOR'S WORK PRODUCT

I HEREBY CERTIFY THAT THE ABOVE DESCRIBED PROPERTY HAS BEEN SURVEYED UNDER MY DIRECTION AND THAT THE ABOVE MAP IS A TRUE REPRESENTATION THEREOF AND SHOWS THE SIZE AND LOCATION OF THE PROPERTY AND ITS EXTERIOR BOUNDARIES. THIS SURVEY IS MADE FOR THE USE OF THE PRESENT OWNERS OF THE PROPERTY, AND ALSO THOSE WHO PURCHASE, MORTGAGE, OR GUARANTEE THE TITLE THERETO WITHIN ONE YEAR FROM THE DATE HEREOF.

DATED: July 18, 2000

PETER S. GORDON R.L.S. 2101

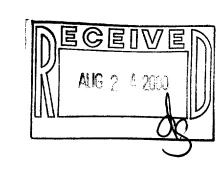

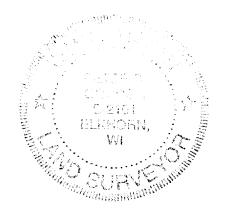

ASSOCIATES, INC. WC
ECTURE - SURVEYING HA


FARRIS, HANSEN & ASSOCIAT

ENGINEERING - ARCHITECTURE - SU
7 RIDGWAY COURT P.O. BOX 4:
ELKHORN, WISCONSIN 53121

REVISIONS

PROJECT NO.
5644
DATE:

07-18-00 SHEET NO. 1 OF 1

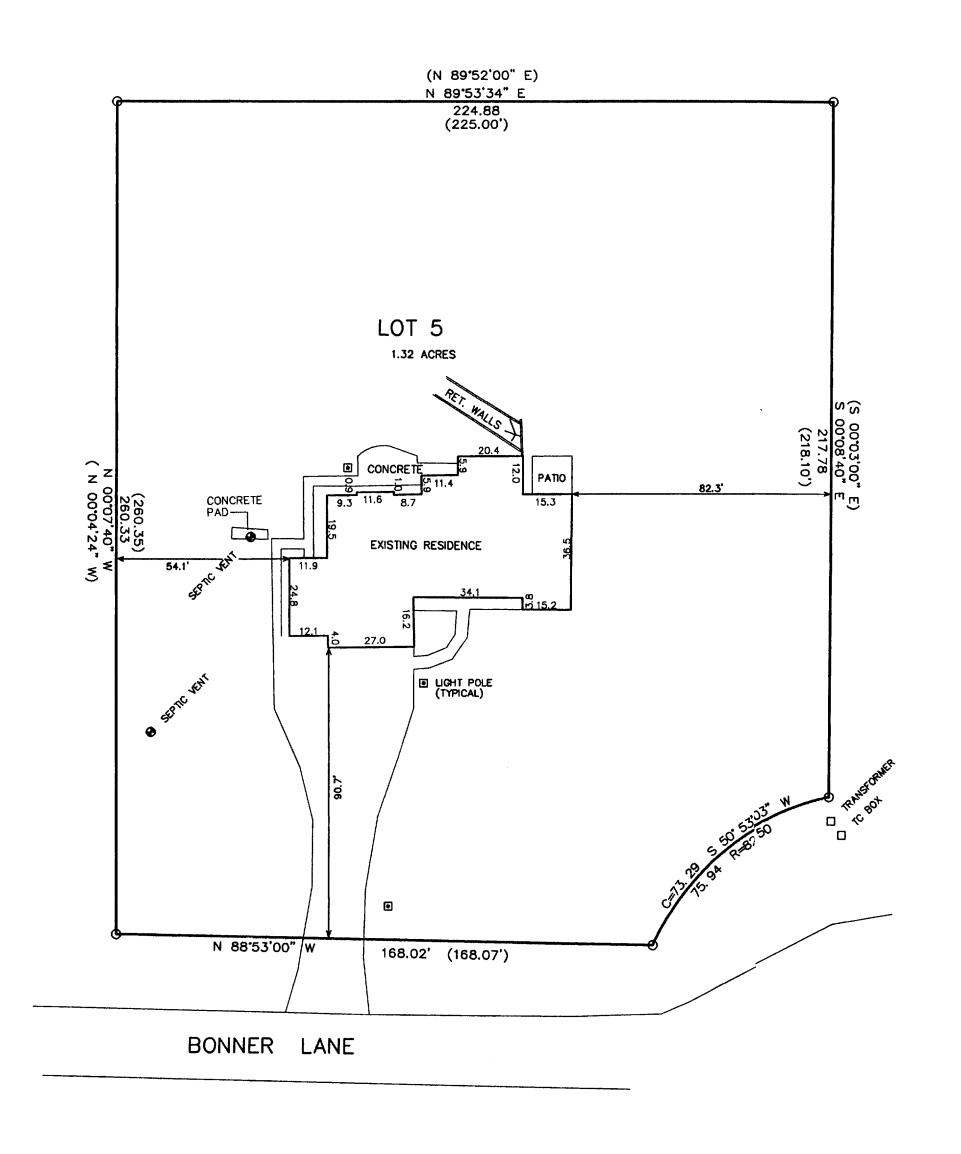

90 80 70 60 ⁵⁰ 40 30 20 10

MAP SCALE IN FEET ORIGINAL 1" = 30'