

# PLAT OF SURVEY


ORDERED BY:

CENTURY 21 ZENK REALTY, LLC.  
804 N. WISCONSIN ST.  
ELKHORN, WI  
53121

DATE: 9 / 29 / 2000

## DESCRIPTION

LOTS 59 AND 62 OF HILLSIDE SUBDIVISION, LOCATED IN SECTION 5 T.1.N. , R.16.E. , WALWORTH COUNTY, WISCONSIN.

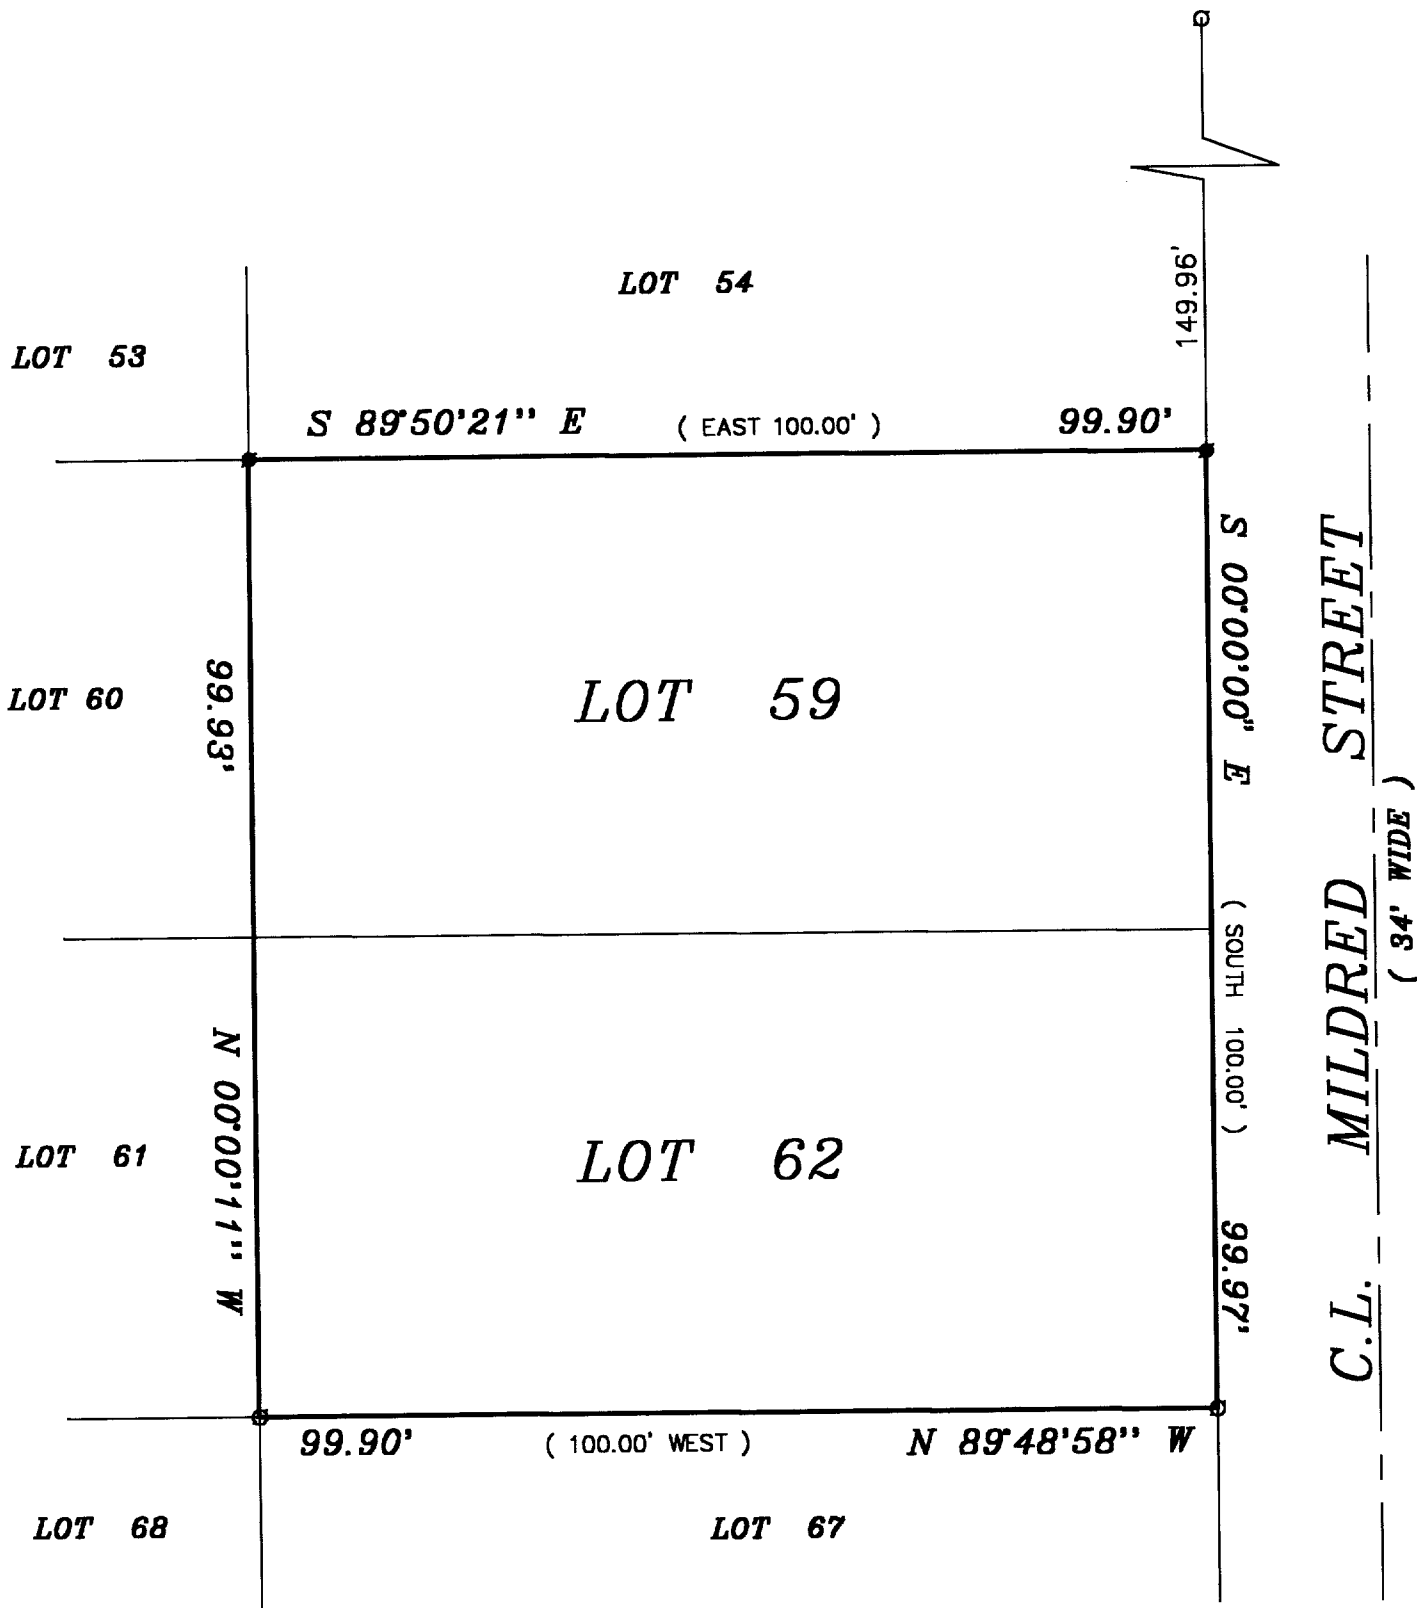

### LEGEND

- FOUND IRON PIPE
- SET IRON PIPE
- (XXXX) RECORDED AS

NOTE: BEARINGS ARE REFERENCED TO THE RECORD PLAT OF HILLSIDE SUBDIVISION


THE ABOVE MAP IS A TRUE REPRESENTATION THEREOF AND SHOWS THE SIZE AND LOCATION OF ALL THE PROPERTY, EXTERIOR BOUNDARIES, THE LOCATION OF ALL VISIBLE BOUNDARY FENCES, APPARENT EASEMENTS, ROADWAYS AND VISIBLE ENCROACHMENTS, IF ANY

THIS SURVEY IS MADE FOR THE USE OF THE PRESENT OWNERS OF THE PROPERTY, AND ALSO THOSE WHO PURCHASE, MORTGAGE OR GUARANTEE TITLE THERETO WITHIN ONE (1) YEAR FROM DATE HERETO.

*John P. Krott*  
JOHN P. KROTT, R.L.S. 2258



NOTE: THIS IS NOT A CERTIFIED COPY UNLESS SEAL IS IN RED.  
JOB NUMBER: 00512-EH00040&43

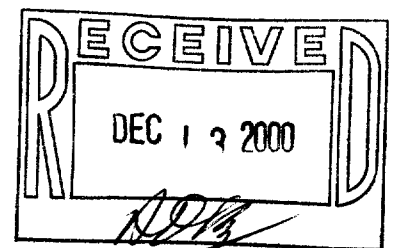

**JK SURVEYING**  
N3705 WILLOW BEND LANE  
LAKE GENEVA, WI 53147  
(262)-248-3697

EA-40  
EA-43

116-570