
ABELL SURVEYING & MAPPING

1140 SEQUOIA STREET . DELAVAN, WISCONSIN 53115 262-728-6737

(EXISTING 32' PRIVATE ROADWAY)



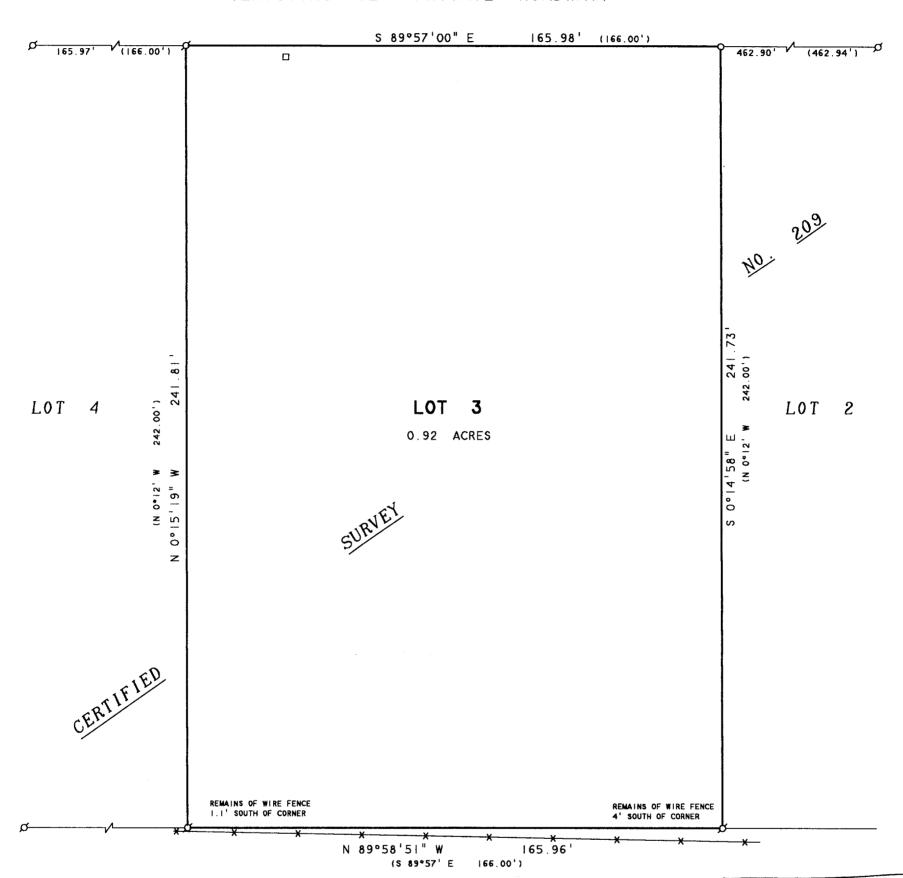

PLAT OF SURVEY OF

LOT 3. CERTIFIED SURVEY NUMBER 209, LOCATED IN THE NORTH 1/2 OF THE SOUTHWEST 1/4 OF SECTION 15. TIN, R16E, WALWORTH COUNTY, WISCONSIN.



SCALE | "=30"

LEGEND

Ø - IRON PIPE FOUND O - I" DIA. IRON PIPE SET □ - UTILITY PED X - REMAINS OF WIRE FENCE () - RECORDED AS

NOTE: BEARINGS ARE REFERENCED TO THE RECORDED CERTIFIED SURVEY MAP.

ORDERED BY: MABLE MISENER P.O. BOX 115 WALWORTH, WI 53184 I HEREBY CERTIFY THAT I HAVE SURVEYED THE ABOVE DESCRIBED PROPERTY AND THAT THE ABOVE MAP IS A TRUE REPRESENTATION THEREOF AND SHOWS THE SIZE AND LOCATION OF THE PROPERTY, ITS EXTERIOR BOUNDARIES, THE LOCATION OF ALL VISIBLE STRUCTURES AND DIMENSIONS OF ALL PRINCIPAL BUILDINGS THEREON, BOUNDARY FENCES, APPARENT EASEMENTS, ROADWAYS AND VISIBLE ENCROACHMENTS, IF ANY, TO THE BEST OF MY KNOWLEDGE AND BELIEF.

THIS SURVEY IS MADE FOR THE USE OF THE PRESENT OWNERS OF THE PROPERTY, AND ALSO THOSE WHO PURCHASE, MORTGAGE, OR GUARANTEE THE TITLE THERETO WITHIN ONE (I) YEAR FROM-DATE HEREON.

DAVID F. ABELL

WISCONSIN REGISTERED LAND SURVEYOR. S-1596

April 19, ZOO1

DATE
NOTE: THIS IS NOT A CERTIFIED COPY UNLESS SEALED.