
PREPARED FOR:

STONEGATE

LOCATION:

Double Drive, Walworth, Wisconsin

LEGAL DESCRIPTION: LOT 17 HIGH CREST ESTATES located in the Northwest 1/4 of the Southeast 1/4, the Northeast 1/4 of the Southwest 1/4 and the Northwest 1/4 of the Southwest 1/4 of Section 23, T 1 N, R 16 E, Town of Walworth, Walworth County, Wisconsin.

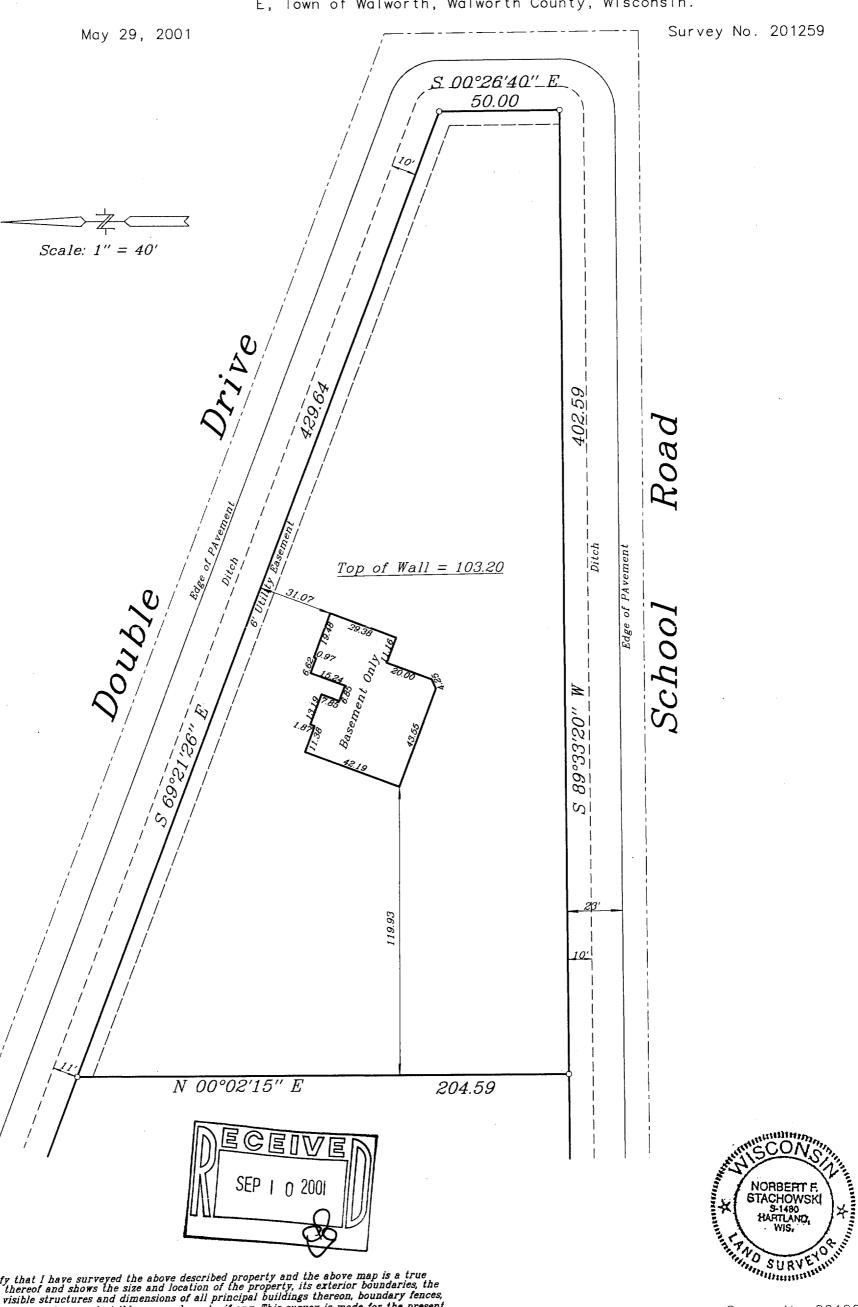

I hereby certify that I have surveyed the above described property and the above map is a true representation thereof and shows the size and location of the property, its exterior boundaries, the location of all visible structures and dimensions of all principal buildings thereon, boundary fences, apparent easements, roadway and visible encroachments, if any. This survey is made for the present owners of the property, and also those who purchase, mortgage, or guarantee, the title thereto within one (1) year from date hereof.

Survey No. 201064

METROPOLITAN ENGINEERING, INC.

20875 CROSSROADS CIRCLE, SUITE 150, WAUKESHA, WI. 53186 PH. (262) 782-2221 FAX 782-4426

EHCE-17