


PLAT OF SURVEY

PREPARED FOR: STONEGATE
 LOCATION: Double Drive, Walworth, Wisconsin
 LEGAL DESCRIPTION: LOT 17 HIGH CREST ESTATES located in the Northwest 1/4 of the Southeast 1/4, the Northeast 1/4 of the Southwest 1/4 and the Northwest 1/4 of the Southwest 1/4 of Section 23, T 1 N, R 16 E, Town of Walworth, Walworth County, Wisconsin.

May 29, 2001

Survey No. 201259

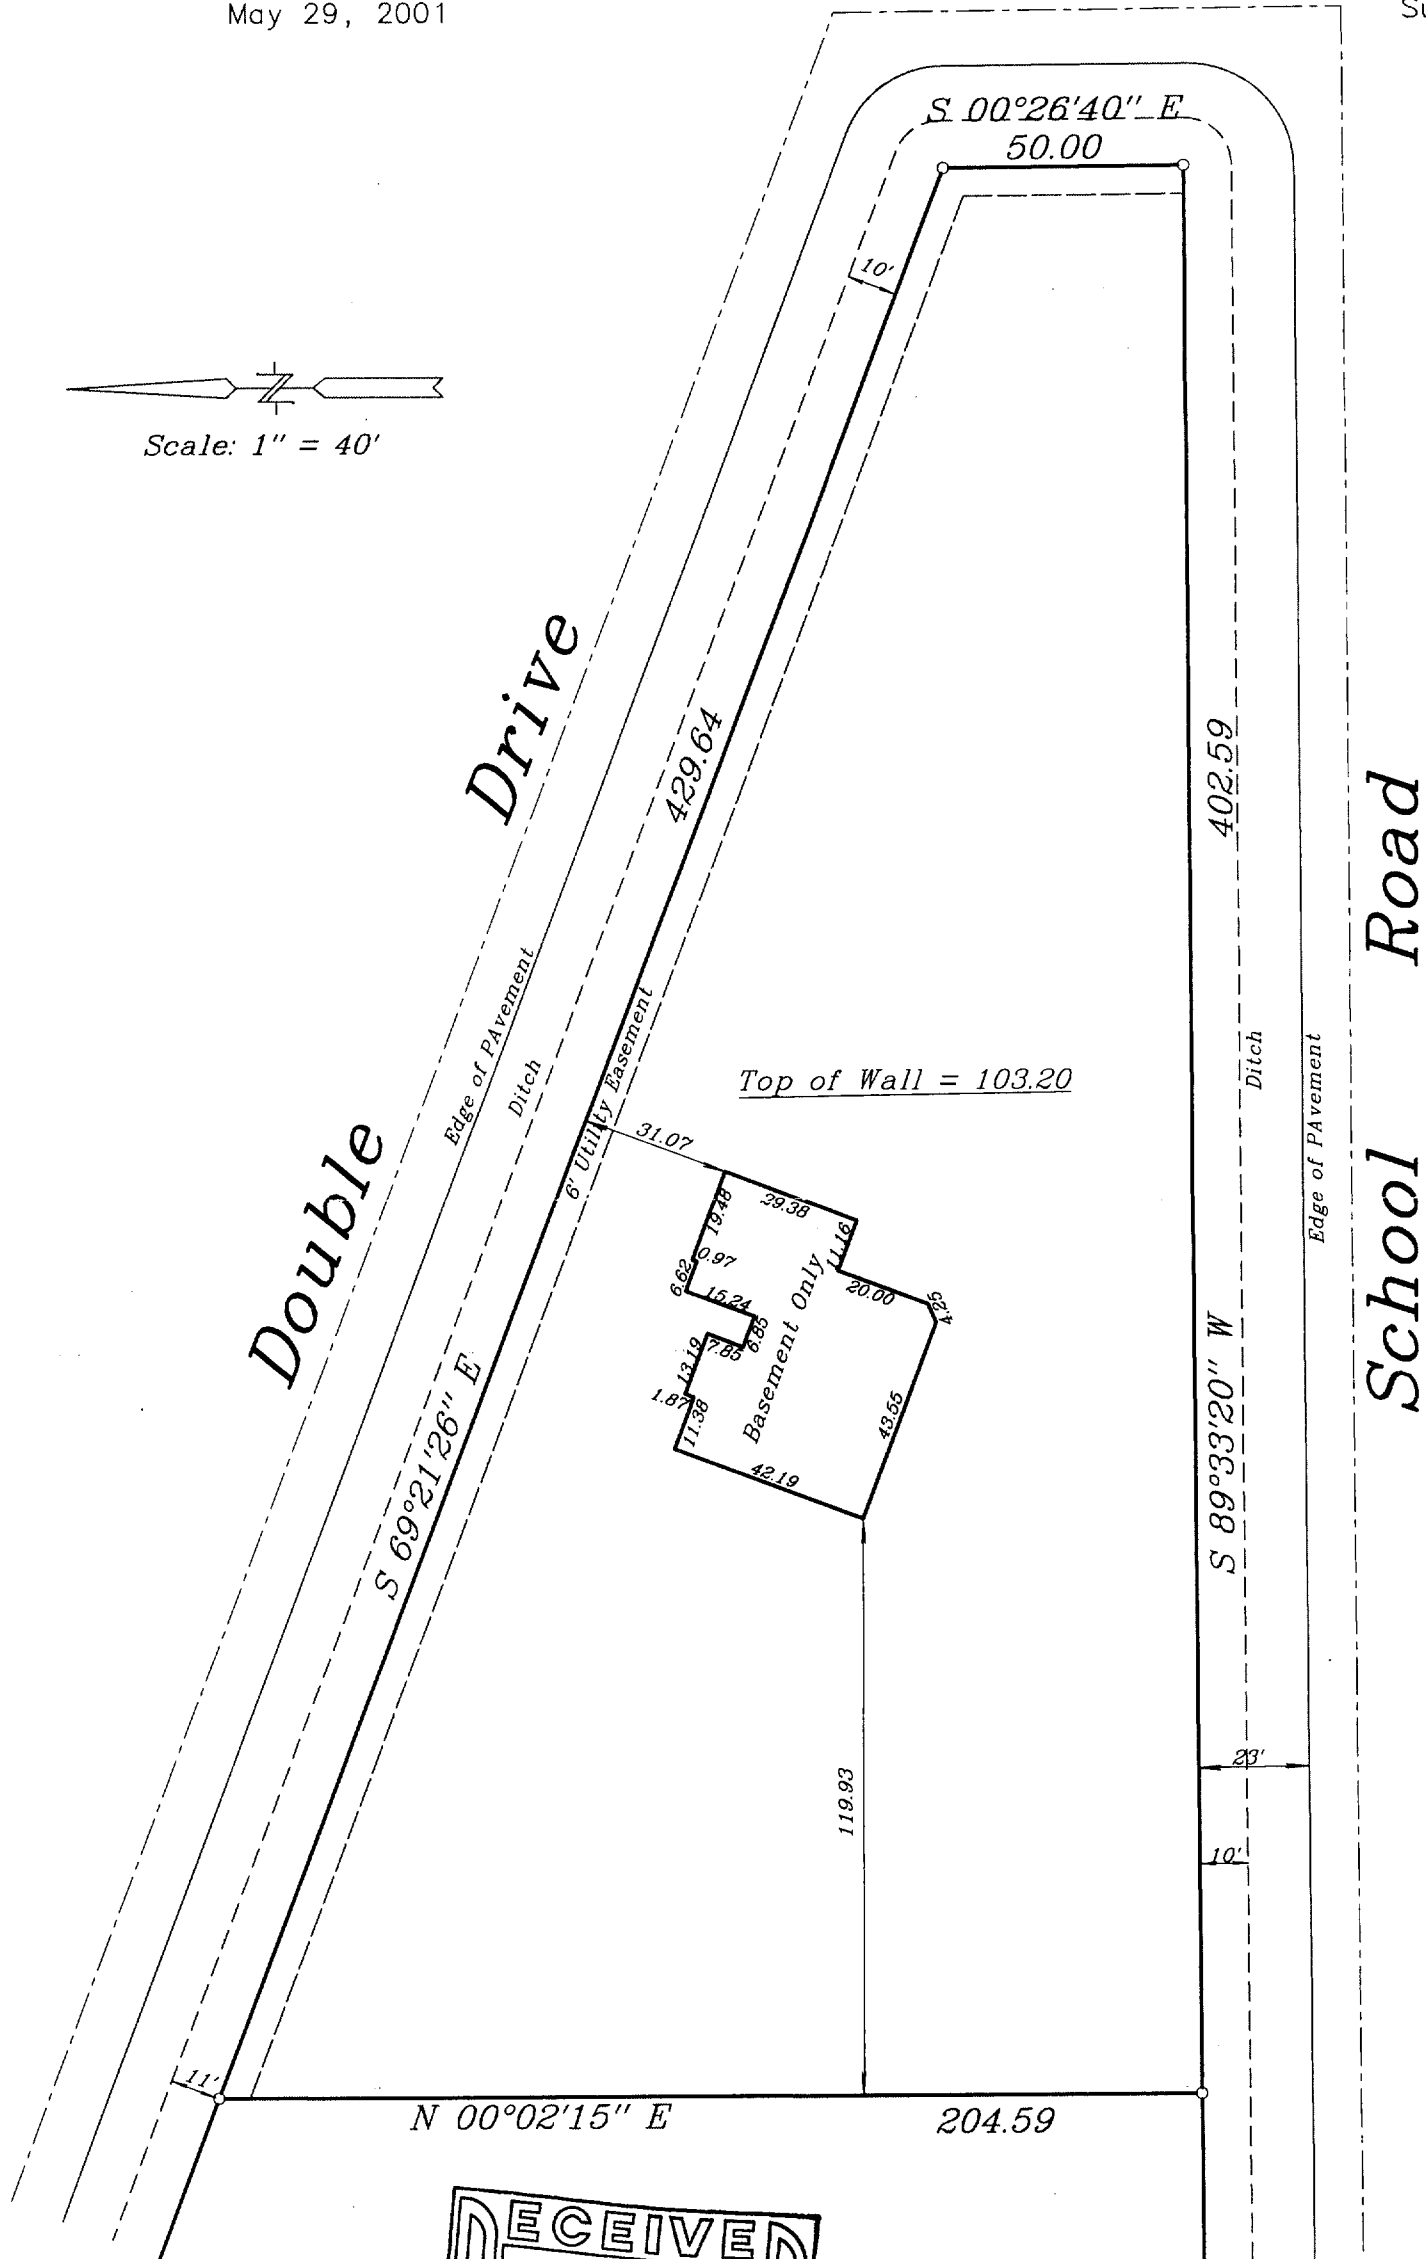

Scale: 1" = 40'

RECEIVED
 SEP 10 2001



I hereby certify that I have surveyed the above described property and the above map is a true representation thereof and shows the size and location of the property, its exterior boundaries, the location of all visible structures and dimensions of all principal buildings thereon, boundary fences, apparent easements, roadway and visible encroachments, if any. This survey is made for the present owners of the property, and also those who purchase, mortgage, or guarantee, the title thereto within one (1) year from date hereof.

Signed
 EHCE-17 116-586

Survey No. 201064

METROPOLITAN ENGINEERING, INC.
 20875 CROSSROADS CIRCLE, SUITE 150, WAUKESHA, WI. 53186
 PH. (262) 782-2221 FAX 782-4426