


ABELL SURVEYING & MAPPING


1140 SEQUOIA STREET • DELAVAN, WISCONSIN 53115
262-728-6737

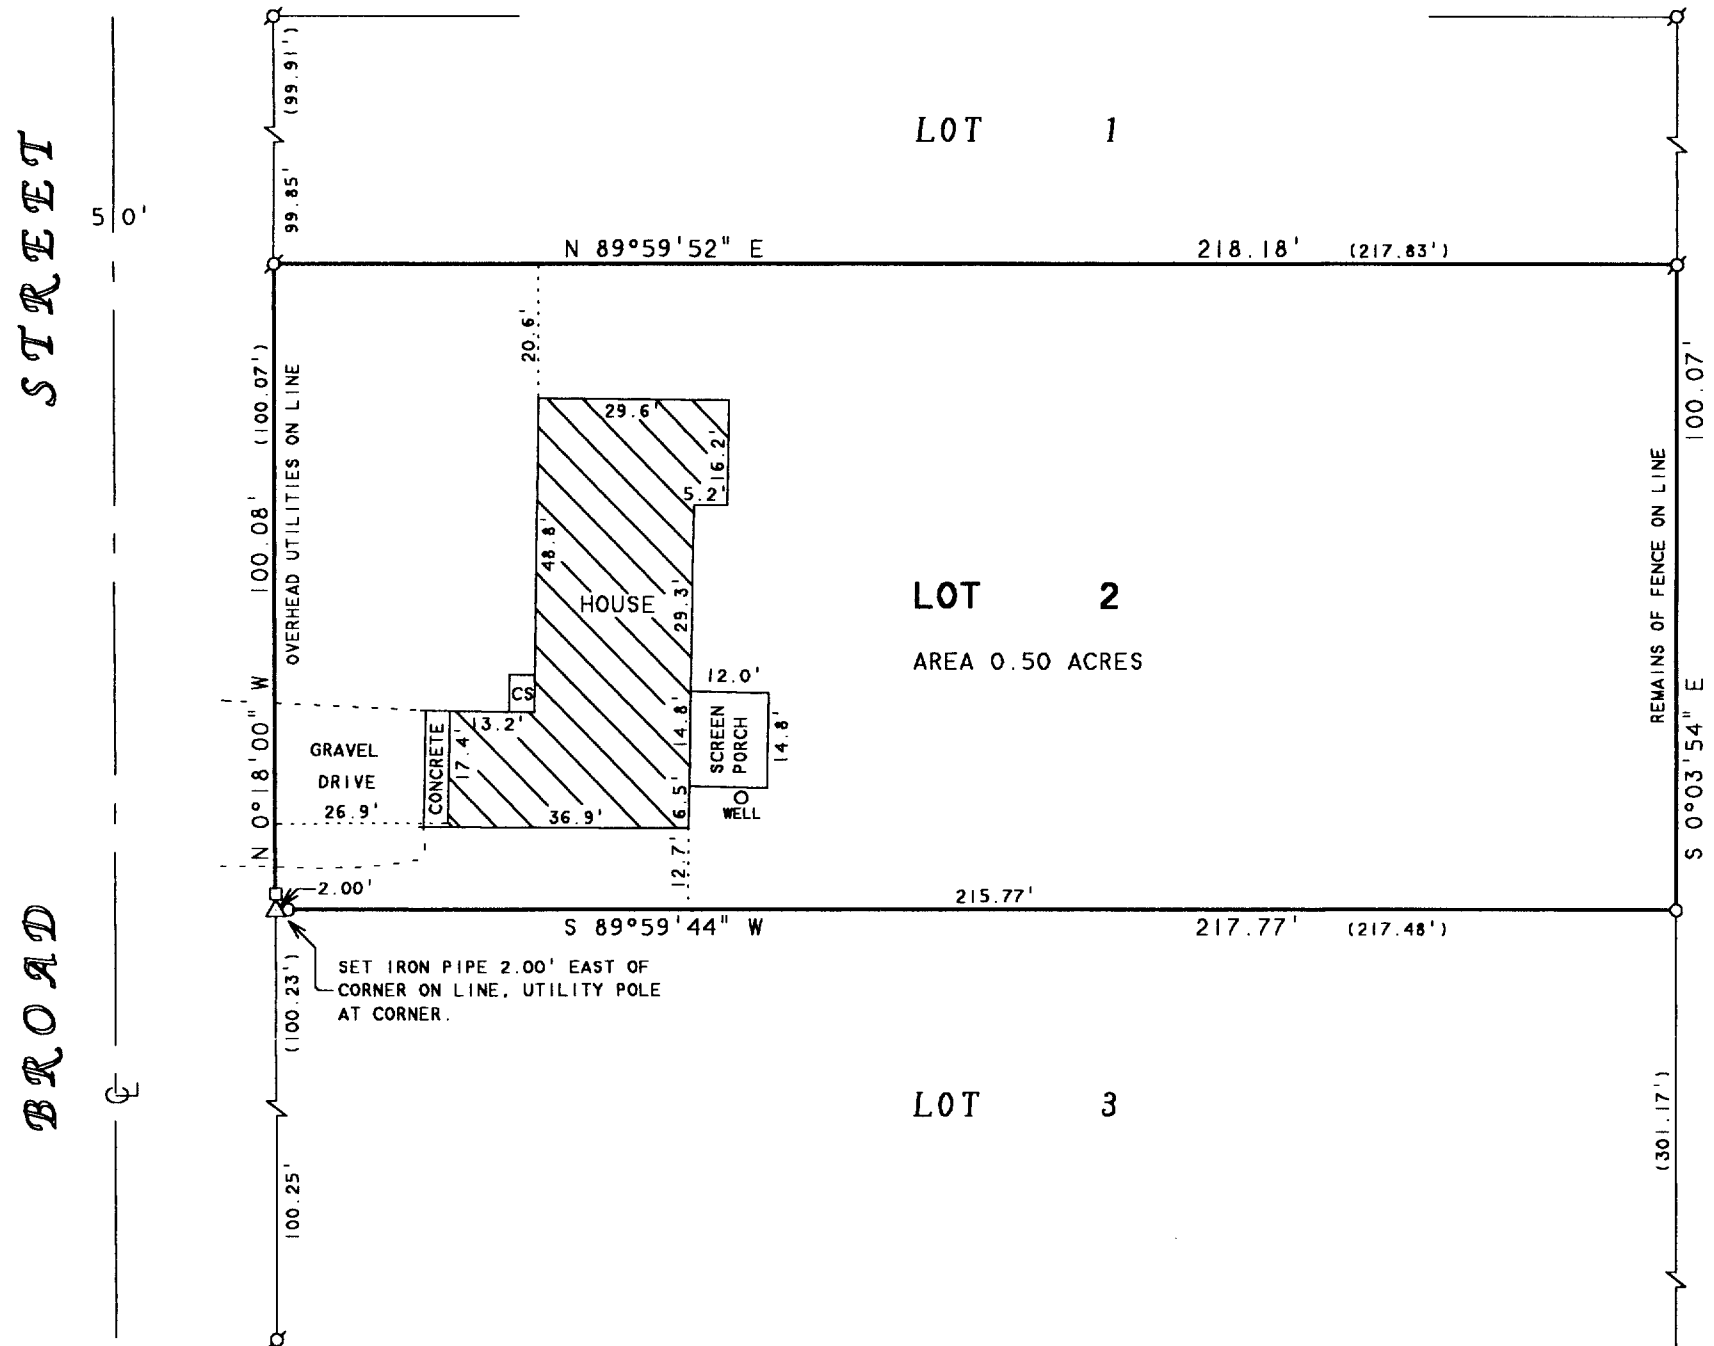

NOTE: BEARINGS ARE REFERENCED TO EXISTING SURVEY RECORDS.

PLAT OF SURVEY OF

LOT 2, ADDITION 1 TO ROBBINS SUBDIVISION,
LOCATED IN T1N. R16E. WALWORTH COUNTY,
WISCONSIN.

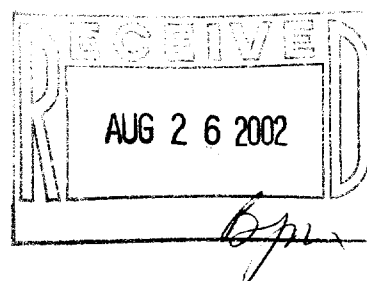

SCALE 1"=30'

LEGEND

- -IRON PIPE FOUND
- -1" DIA. IRON PIPE SET
- CS -CONCRETE STOOP
- △ -UTILITY POLE
- -UTILITY PED.
- () -RECORDED AS

I HEREBY CERTIFY THAT I HAVE SURVEYED THE ABOVE DESCRIBED PROPERTY AND THAT THE ABOVE MAP IS A TRUE REPRESENTATION THEREOF AND SHOWS THE SIZE AND LOCATION OF THE PROPERTY, ITS EXTERIOR BOUNDARIES, THE LOCATION OF ALL VISIBLE STRUCTURES AND DIMENSIONS OF ALL PRINCIPAL BUILDINGS THEREON, BOUNDARY FENCES, APPARENT EASEMENTS, ROADWAYS AND VISIBLE ENCROACHMENTS, IF ANY, TO THE BEST OF MY KNOWLEDGE AND BELIEF.

THIS SURVEY IS MADE FOR THE USE OF THE PRESENT OWNERS OF THE PROPERTY, AND ALSO THOSE WHO PURCHASE, MORTGAGE, OR GUARANTEE THE TITLE THERETO WITHIN ONE (1) YEAR FROM DATE HEREON.

[Signature]

DAVID F. ABELL
WISCONSIN REGISTERED LAND SURVEYOR, S-1596

ORDERED BY: DARREN DASE
N2462 BROAD STREET
DELAVAN, WI 53115

July 3, 2002

DATE JOB NUMBER - 02100
NOTE: THIS IS NOT A CERTIFIED COPY UNLESS SEALED.

116-631

ERA 2