

Plat of Survey

of

Lot 1 of Certified Survey Map No. 1359,

recorded in Vol. 6 of Certified Survey Maps of Walworth County on Page 198 and located in the Northwest 1/4 of the Northeast 1/4 of Section 8, Town 1 North, Range 16 East, Town of Walworth, Walworth County, Wisconsin.

Surveyed for: **Godfrey, Leibsle, Blackburn & Howarth, S.C.**
11 North Wisconsin Street ** Post Office Box 260
Elkhorn, Wisconsin. 53121

Tax Parcel
EW 600001B

Bearings reference to Certified
Survey Map No. 1359.

Survey Date: April 28, 2003.
Revisions:

Scale in Feet
1" = 30'
0' 15' 30' 60'

Jensen & Olson Land Surveying, LLC
45 South Wisconsin Street P.O. Box 322
Elkhorn, Wisconsin. 53121
Telephone (262) 723-3434
Facsimile (262) 723-8044

Legend
Found County Section Corner
Found Iron Pipe Set Iron Pipe
Recorded Information
Concrete Cover
Utility Pole
Cantilevered Window
Asphalt Surface Concrete

Sheet 1 of 1 Sheets
Job Reference Number
2003.042



2003.042

North 1/4 Corner
Section 6-1-16.

County Trunk Highway 0
(100' Wide)

(N1°30'38"W) State Plane
N0°21'09"E 2837.64'
West line of the Northeast 1/4 of Section 8-1-16.

Center 1/4 Corner
Section 6-1-16.

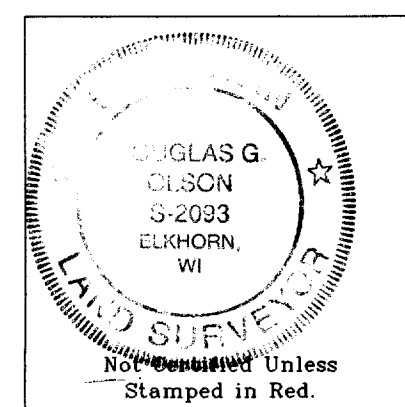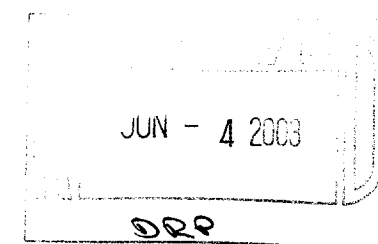

Notes: 1) This survey plat is not certified unless signed and sealed in red ink.

2) This survey is subject to Wisconsin lien laws. This Plat of Survey is the notice of intent to file lien. Lien waiver required.

Driveway continues onto and provides access to Tax Parcel EW 600001B.

Sidewalks continue onto and provide access to Tax Parcel EW 600001B.

Centerline of Ditch
Appears to provide drainage from Tax Parcel EW 600001B to Tax Parcel EW 600001.

Found iron pipe bent - reset.

Lot 2
C.S.M. 1359

Copyright © 2003 by Jensen & Olson Land Surveying, LLC.

All rights reserved. No part of this survey plat may be reproduced or transmitted in any form by any means - graphic, electronic, or mechanical, including photocopying, tracing, or information storage and retrieval systems - without permission in writing from Douglas G. Olson, Jensen & Olson Land Surveying, LLC.

I hereby certify that I have surveyed the above described property and the map hereon is correct to the best of my professional knowledge and belief and shows the size and location of the property, its exterior boundaries, the location and dimensions of all visible structures thereon, boundary fences, apparent easements and roadways and visible encroachments, if any.
This survey is made for the exclusive use of the present owners of property, and also those who purchase, mortgage or guarantee title thereto, within one year from the date hereof.

Douglas G. Olson
Wisconsin Registered Land Surveyor - 2093