

## DUNHAM SURVEYING, S.C. SURVEYING & SUBDIVIDING DELAVAN, WISCONSIN 53115

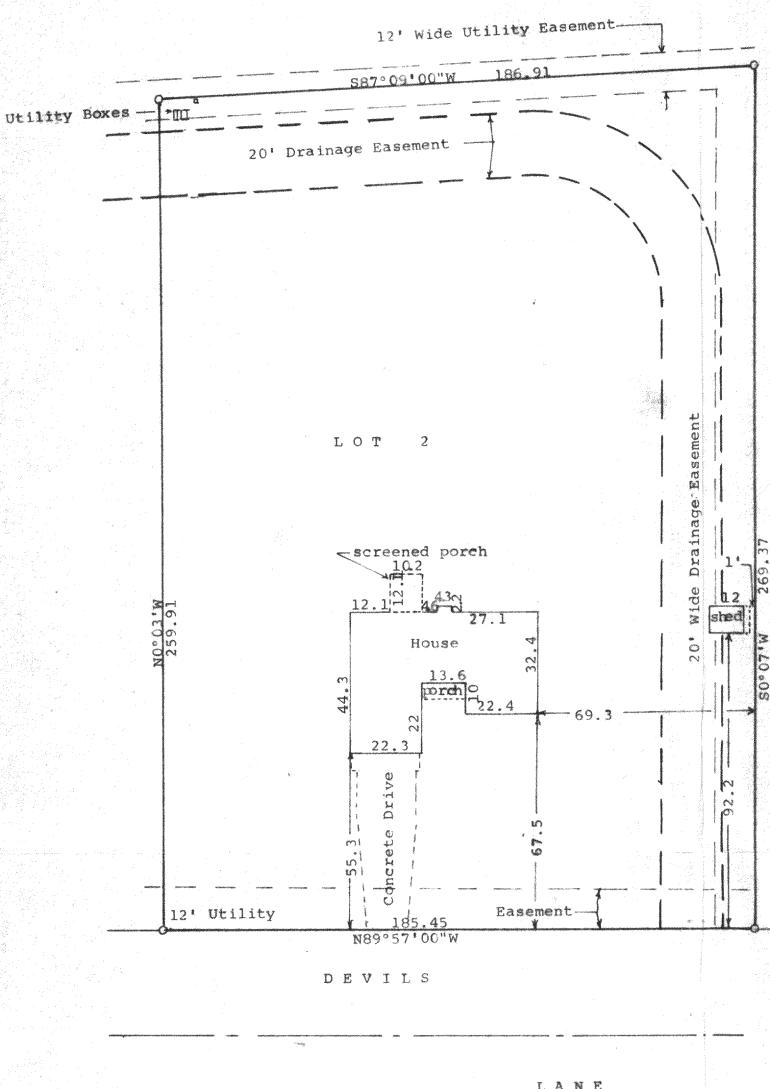

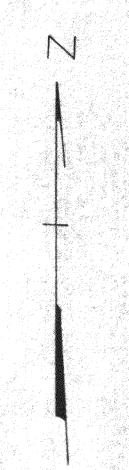


Scale - 1" = 30' O = Iron Pipe Found Survey ordered by: Prudential Select Properties 623 West Main Street Lake Geneva, WI 53147 Bearings are referenced to Certified Survey Map No. 2230

LANE

STATE OF WISCONSIN) SS COUNTY OF WALWORTH)

I, George T. Dunham, Surveyor, certify that I have surveyed the property described as follows: Lot 2, Certified Survey Map No. 2230, located in the Southwest & of

Section 23, T 1 N, R 16 E, Walworth County, Wisconsin, and that the map shown hereon is a correct representation thereof and shows the size and location of the property, its exterior boundaries, the location of all visible structures and dimensions of all principal buildings thereon, boundary fences, apparent easements, roadways and visible encroachments, if any, and that I have surveyed the property hereon described, according to the official records, to the best of my knowledge and belief. July 26, 2001

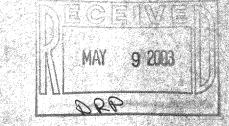

George T. Dunham, Surveyor

