## ABERNATHY and ASSOCIATES

Kenneth B. Abernathy Jr.

Wisconsin Registered Land Surveyor

W4056 BRAY RD. ELKHORN, WI. 53121

PHONE: (262) 723-4260 (OFFICE) (262) 723-7209 (FAX)

S-1594 **Email:** abernathy@elknet.net

SURVEY PLAT

**LOT 1 OF CERTIFIED SURVEY MAP NO. 2571** LOCATED IN THE SW 1/4 OF THE NW 1/4 OF SECTION 5, TOWN 1 NORTH, RANGE 16 EAST, WALWORTH COUNTY, WISCONSIN.

## Legend

FOUND IRON PIPE

FOUND IRON ROD

4115 North U.S. Highway 51 Janesville, Wi. 53545-9674

FOUND CONCRETE MONUMENT

CHISEL CUT IN CONCRETE


SET IRON ROD, 24" LONG, WEIGHING 1.5 LBS./LINEAL FT., 3/4" DIA.

FOUND BRASS CAPPED MONUMENT

SET IRON ROD, 30" LONG, WEIGHING 4.5 LBS./LINEAL FT., 1-11/16" DIA.

RECORDED AS DIMENSION

× × EXISTING FENCE

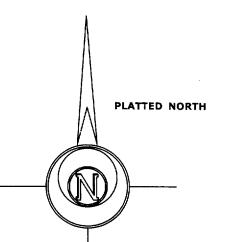

REVISED 1/16/04 AS BUILT FOUNDATION


FOUNDATION

"I hereby certify that the above described property has been surveyed by me or under my direction and that the above map is a true representation thereof and shows the size and location of the property, its exterior boundaries, the location of all visible structures and dimensions of all principal buildings thereon, boundary fences, apparent easements, roadways and visible encroachments, if any." if any."

"This survey is made for the use of the present owners of the property, and also those who purchase, mortgage, or guarantee the title thereto within one year from the date hereof."

KENNETH B. ABERNATHY, JR. WISCONSIN REGISTERED LAND SURVEYOR,

Date: OCT. 1, 2003

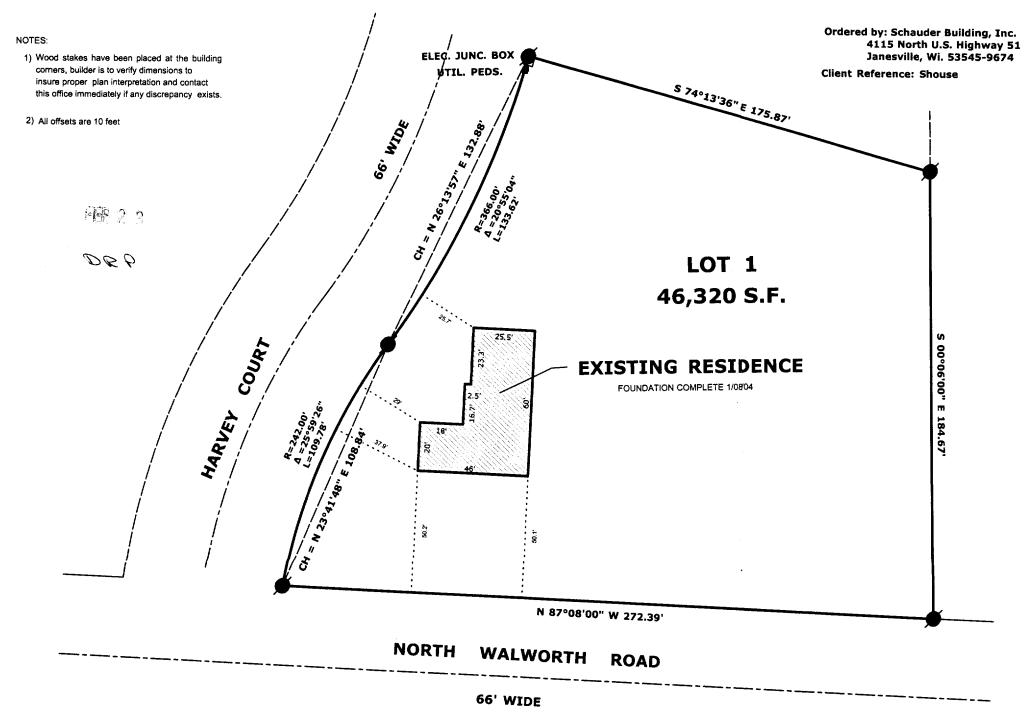

EA2571-