



ERNIE TUCHSCHERER
GENEVA LAKE DREAM HOMES, LLC
P.O. BOX 259
FONTANA, WI 53125

ENGINEERING -- ARCHITECTURE -- SURVEYING
7 RIDGWAY COURT P.O. BOX 437
ELKHORN, WISCONSIN 53121
OFFICE: (262) 723-2098 FAX: (262) 723-5886

PROJECT NO.	6462
DATE:	1/12/04
SHEET NO.	1 OF 1

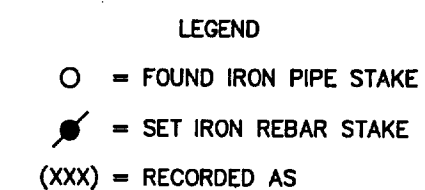

RECEIVED
APR 5 2004
KW

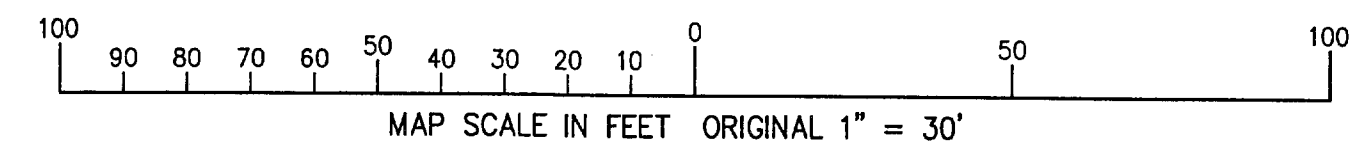


NOTE: COPIES OF THIS MAP TO WHICH THE FOLLOWING CERTIFICATE WILL APPLY SHOW THE SURVEYOR'S ORIGINAL SEAL AND SIGNATURE IN RED INK. COPIES BY ANY OTHER MEANS MAY HAVE ALTERATIONS WHICH DO NOT REPRESENT THE SURVEYOR'S WORK PRODUCT.

I HEREBY CERTIFY THAT THE ABOVE DESCRIBED PROPERTY HAS BEEN SURVEYED UNDER MY DIRECTION AND THAT THE ABOVE MAP IS A TRUE REPRESENTATION THEREOF AND SHOWS THE SIZE AND LOCATION OF THE PROPERTY AND ITS EXTERIOR BOUNDARIES. THIS SURVEY IS MADE FOR THE USE OF THE PRESENT OWNERS OF THE PROPERTY, AND ALSO THOSE WHO PURCHASE, MORTGAGE, OR GUARANTEE THE TITLE THERETO WITHIN ONE YEAR FROM THE DATE HEREOF.

DATED: JANUARY 12, 2004

REVISED 03-03-2004
TO SHOW SIZE & LOCATION OF
RESIDENCE AS BUILT


PETER S. GORDON R.L.S. 2101

3/3/2004 X:\Projects\6462\Dead\SURVEY

EHCE-8

116-724