

# LAND-MARK SURVEYING

Mark L. Miritz

Wisconsin Registered Land Surveyor S-2582


N9330 Knuteson Drive  
Whitewater, WI 53190  
Phone: (262) 495-3284  
FAX: (262) 495-8421  
LAND-MARKSURVEYING.COM

## PLAT OF SURVEY

LOTS 45, 46, 51 - 54 OF HILLIDE SUBDIVISION,  
LOCATED IN SECTION 5, TOWN 1 NORTH, RANGE  
16 EAST, WALWORTH COUNTY, WISCONSIN.

LOTS 45, 46, 51 AND 52  
OWNER: DOROTHY L. BURTON  
W6883 MILDRED ST.  
DELAVER, WI. 53115

LOTS 53 AND 54  
OWNERS: PETER J. and JODI L. MORDINI  
1853 SHEAHEN CT.  
HIGHLAND PARK, IL. 60035

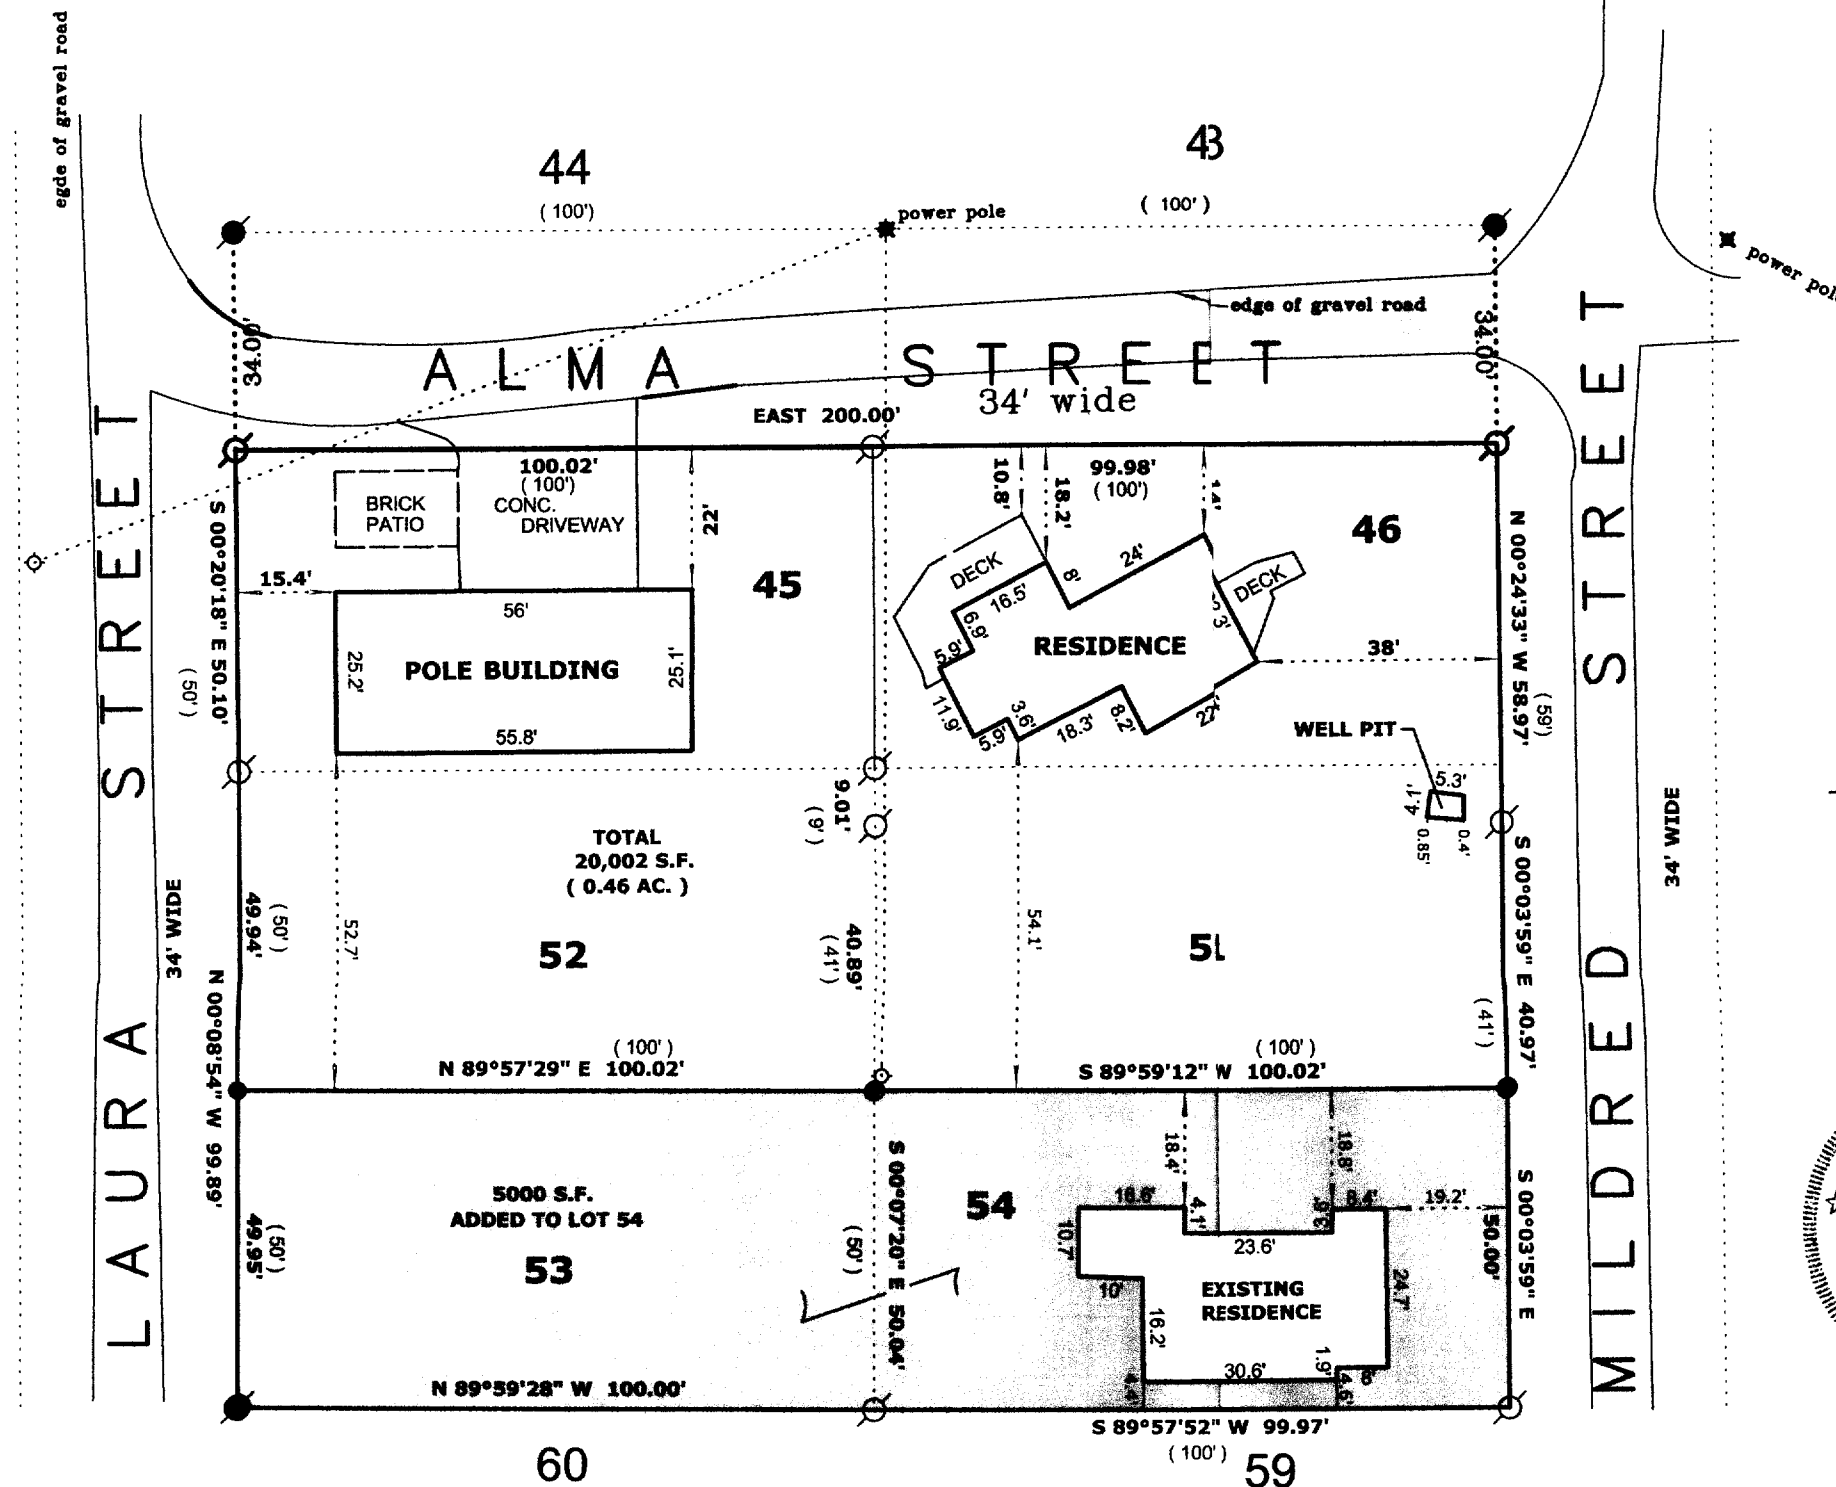

### NOTE:

"THIS LOT LINE ADJUSTMENT BETWEEN  
ADJOINING LAND OWNERS DOES NOT  
CREATE ADDITIONAL LOTS AND THE  
ORIGINAL PARCELS ARE NOT REDUCED  
BELOW THE MINIMUM SIZE REQUIRED BY  
THE WALWORTH COUNTY ZONING  
ORDINANCE."

THE NORTH LINE OF LOTS 45 AND  
46 WAS ASSUMED TO BEAR EAST

### LEGEND

- FOUND IRON PIPE
- FOUND IRON ROD
- FOUND COUNTY MONUMENT
- FOUND CONCRETE MONUMENT
- CHISEL CUT IN CONCRETE
- SET IRON ROD, 24" LONG, WEIGHING  
1.5 LBS./LINEAL FT., 3/4" DIA.
- RECORDED AS DIMENSION
- EXISTING FENCE

SCALE: 1" = 30 FEET

"I hereby certify that the above described property has  
been surveyed by me or under my direction and that the  
above map is a true representation thereof and shows the  
size and location of the property, its exterior boundaries,  
the location of all visible structures and dimensions of all  
principal buildings thereon, boundary fences, apparent  
easements, roadways and visible encroachments, if any."  
"This survey is made for the use of the present owners of  
the property, and also those who purchase, mortgage, or  
guarantee the title thereto within one year from date  
hereof."

Mark L. Miritz

MARK L. MIRITZ  
WISCONSIN REGISTERED  
LAND SURVEYOR S-2582

DATE: MAY 28, 2005 JOB NO. 05.507



16-749

E#00031 E#0036 E#0037