
PREPARED FOR JEFF CURTIS SHOREWEST REALTORS 623 MAIN ST. LAKE GENEVA WI. 53147

PLAT OF SURVEY

OF -

LOT 4 OF CERTIFIED SURVEY MAP NO. 2630 LOCATED IN THE NORTHWEST 1/4 OF THE NORTHEAST 1/4 OF SECTION 11 TOWN 1 NORTH, RANGE 16 EAST, WALWORTH COUNTY, WISCONSIN. PATHFINDER SURVEYING INC. W2888 KRUEGER RD. UNIT "D" LAKE GENEVA WI. 53147 (262) 248-3697



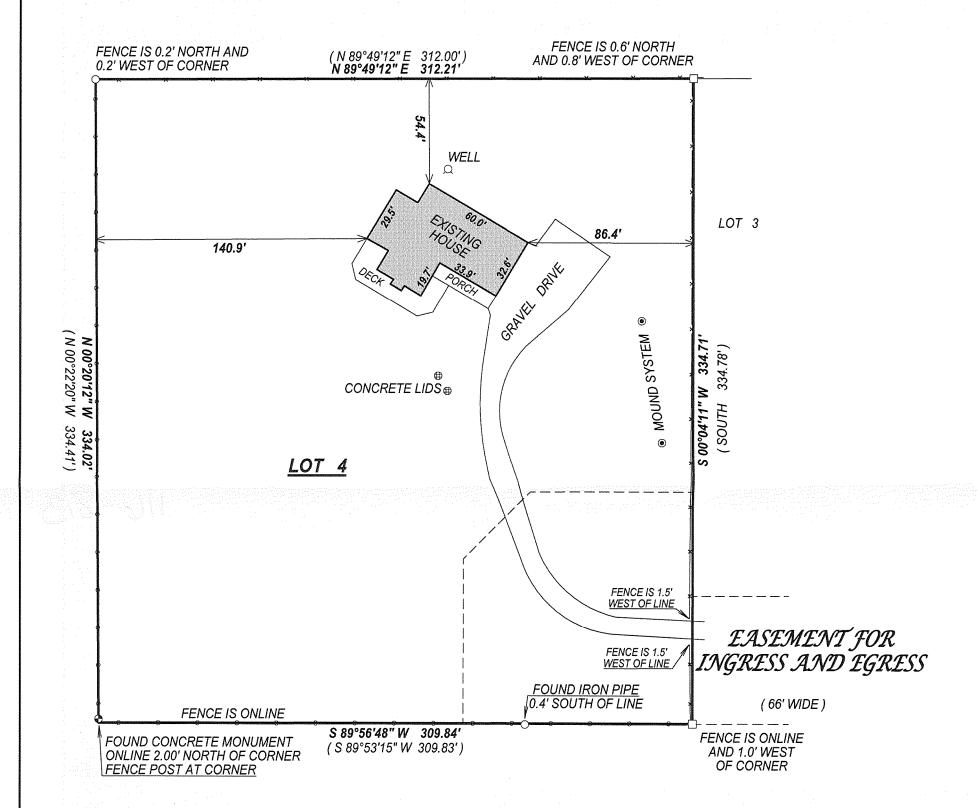

()= RECORDED AS

 $\Box = FOUND IRON BAR$

○ = FOUND TRON PIPE

■ = SET IRON BAR

SCALE 1" = 50'

JOB # 07-334

TAX III # EA263000004



COMPARE LEGAL DESCRIPTION ABOVE AND DRAWING WITH DEED. FOR BUILDING RESTRICTIONS AND EASEMENTS NOT SHOWN, REFER TO DEED, ABSTRACT SOURCES AND LOCAL MUNICIPAL CODES. NOTIFY THE SURVEYOR IMMEDIATELY OF ANY DISCREPANCY.

"I hereby certify that I have surveyed the above described property and that the above map, to the best of my knowledge and belief, is a true representation thereof and shows the size and location of all visible structures, apparent easements and encroachmentsif any."

This survey is made for the present owners of the property, and those who purchase, mortgage, or guarentee the title thereto, within one year from the date hereof.



John Platte

JOHN KROTT S - 2258
Wisconsin Registered Land Surveyor
(original if signed in red)

DATED THIS THE 1st DAY OF AUGUST 2007.

