

FARRIS, HANSEN & ASSOCIATES, INC.

ENGINEERING — ARCHITECTURE — SURVEYING
7 RIDGWAY COURT — P.O. BOX 437 — ELKHORN, WISCONSIN 53121
PHONE: (262) 723-2098 FAX: (262) 723-5886

PLAT OF SURVEY
LOTS 3 AND 6 OF HILLSIDE SUBDIVISION
LOCATED IN SECTION 5, TOWN 1 NORTH, RANGE 16 EAST,
WALWORTH COUNTY, WISCONSIN

— WORK ORDERED BY —
RANDY MARTIN—SHOREWEST REALTORS
830 EAST GENEVA STREET
DELAVER, WI 53115

3. The land referred to in the Commitment is described as follows:

Lots 3 and 6 in Hillside Subdivision, Town of Walworth, Walworth County, Wisconsin.

Tax Key No: EH 00003 AND EH 00005

MARION STREET

{45' WIDE R.O.W.}

EDGE OF GRAVEL

TOTAL AREA
10,012 S.F.

LOT 3

LOT 4

WELL

26.6'

16.3' 2.1' 15.6' 2.1' 11.0'

EXISTING RESIDENCE

DECK

PAVED DRIVEWAY

DECK

LOT 6

LOT 5

OVERHEAD WIRES

ELECTRIC BOX

POWER POLE

WIRE FENCE

CHAIN LINK FENCE


LOT 12

LOT 11

MILDRED STREET

{34' WIDE R.O.W.}

FOUND IRON PIPE
STAKE 0.66' NORTH
OF RECORD CORNER

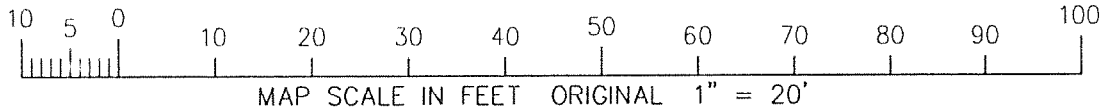


NOTE: COPIES OF THIS MAP TO WHICH THE FOLLOWING CERTIFICATE WILL APPLY SHOW THE SURVEYOR'S ORIGINAL SEAL AND SIGNATURE IN RED INK. COPIES BY ANY OTHER MEANS MAY HAVE ALTERATIONS WHICH DO NOT REPRESENT THE SURVEYOR'S WORK PRODUCT.

I HEREBY CERTIFY THAT THE ABOVE DESCRIBED PROPERTY HAS BEEN SURVEYED UNDER MY DIRECTION AND THAT THE ABOVE MAP IS A TRUE REPRESENTATION THEREOF AND SHOWS THE SIZE AND LOCATION OF THE PROPERTY, ITS EXTERIOR BOUNDARIES, THE LOCATION OF ALL VISIBLE STRUCTURES, AND DIMENSIONS OF ALL PRINCIPLE BUILDINGS THEREON, BOUNDARY FENCES, APPARENT EASEMENTS, ROADWAYS, AND VISIBLE ENCROACHMENTS, IF ANY. THIS SURVEY IS MADE FOR THE USE OF THE PRESENT OWNERS OF THE PROPERTY, AND ALSO THOSE WHO PURCHASE, MORTGAGE, OR GUARANTEE THE TITLE THERETO WITHIN ONE YEAR FROM THE DATE HEREOF.

DATED: AUGUST 20, 2007


8/15/2008-KB
UPDATE SURVEY

PETER S. GORDON

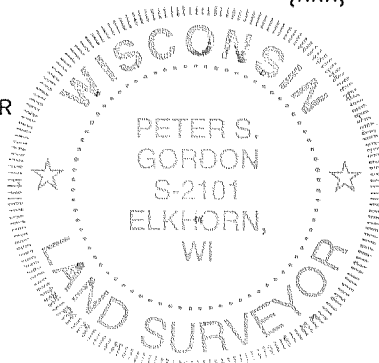

LEGEND

- = FOUND IRON PIPE STAKE
- = SET IRON REBAR STAKE
- {xxx} = RECORDED AS

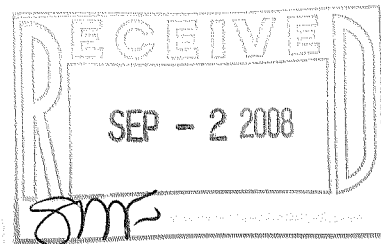

PROJECT: 4491.07
DATE: 8/20/2007
SHEET 1 OF 1

AUG 19 2008 EH-3 FH-5

116-828