
116-980

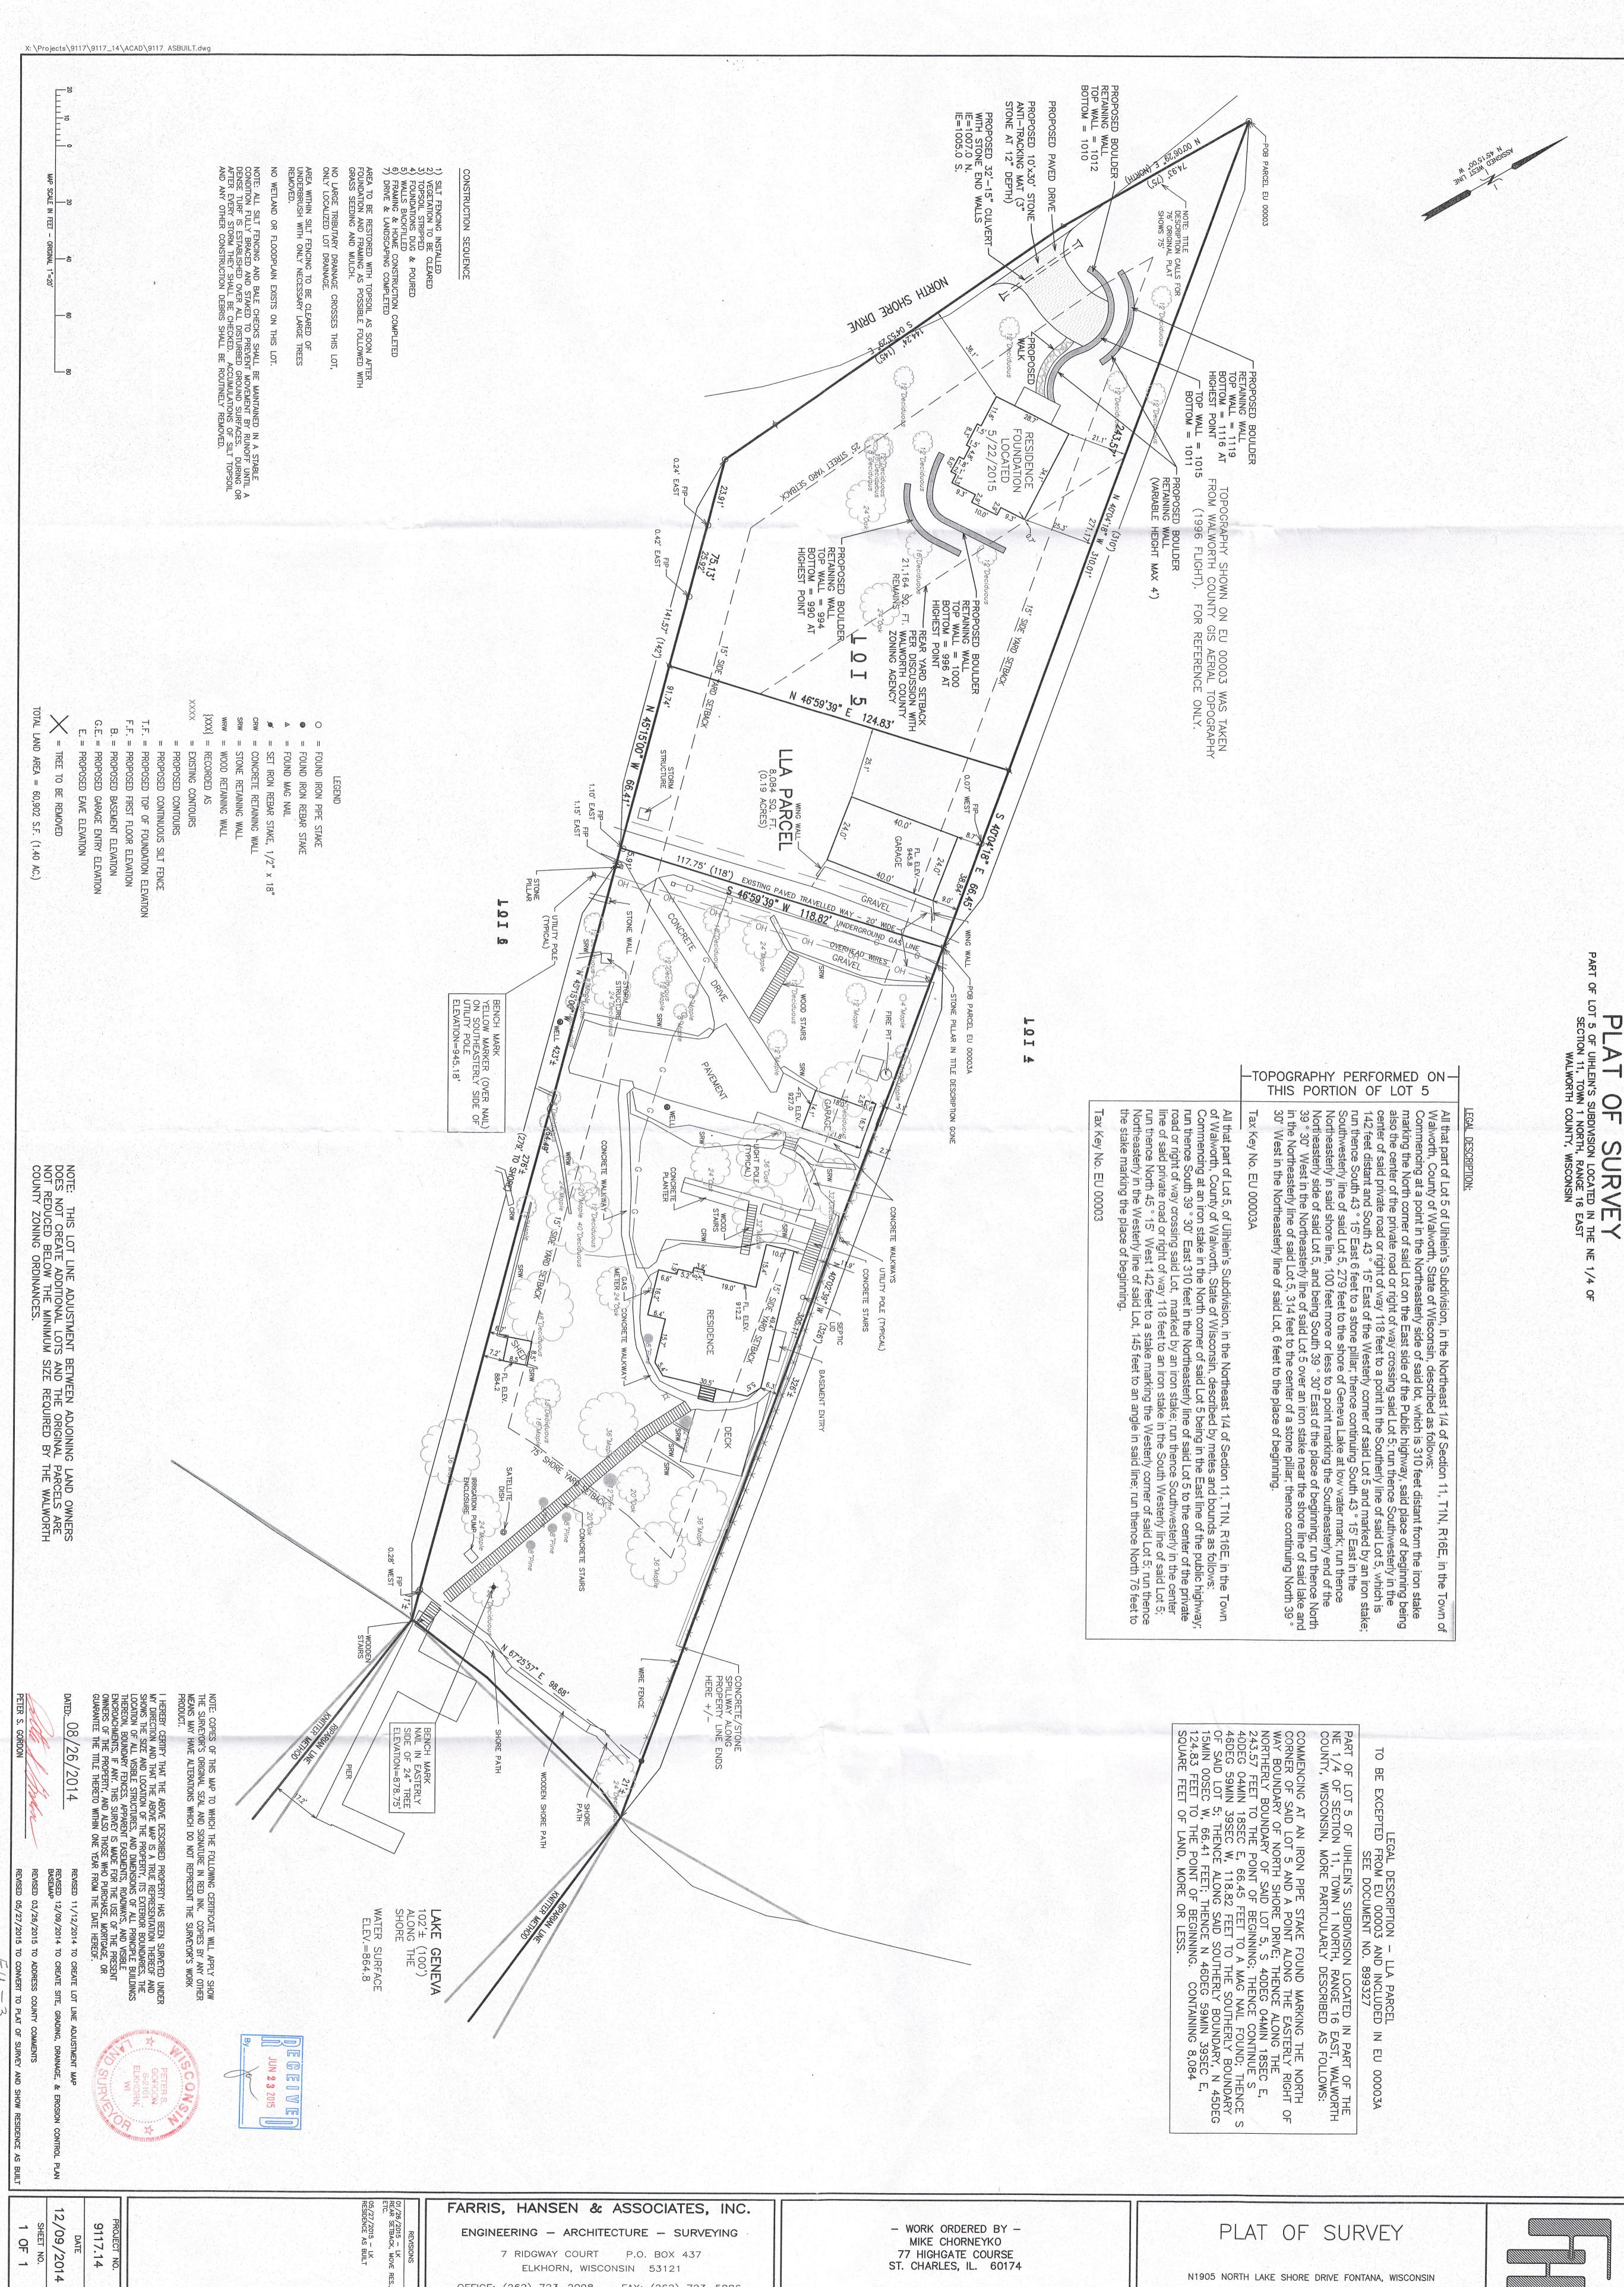

ELKHORN, WISCONSIN 53121

OFFICE: (262) 723-2098 FAX: (262) 723-5886

N1905 NORTH LAKE SHORE DRIVE FONTANA, WISCONSIN