


PLAT OF SURVEY -OF-

LOTS 115 AND 116 OF HILLSIDE SUBDIVISION, A SUBDIVISION BEING PART OF THE NORTHWEST 1/4 AND SOUTHWEST 1/4 OF THE NORTHWEST 1/4 OF SECTION 5, TOWNSHIP 1 NORTH, RANGE 16 EAST OF THE FOURTH PRINCIPAL MERIDIAN, IN THE TOWN OF WALWORTH, COUNTY OF WALWORTH AND STATE OF WISCONSIN.

SURVEY FOR: MILLENNIUM DREAM HOMES LLC

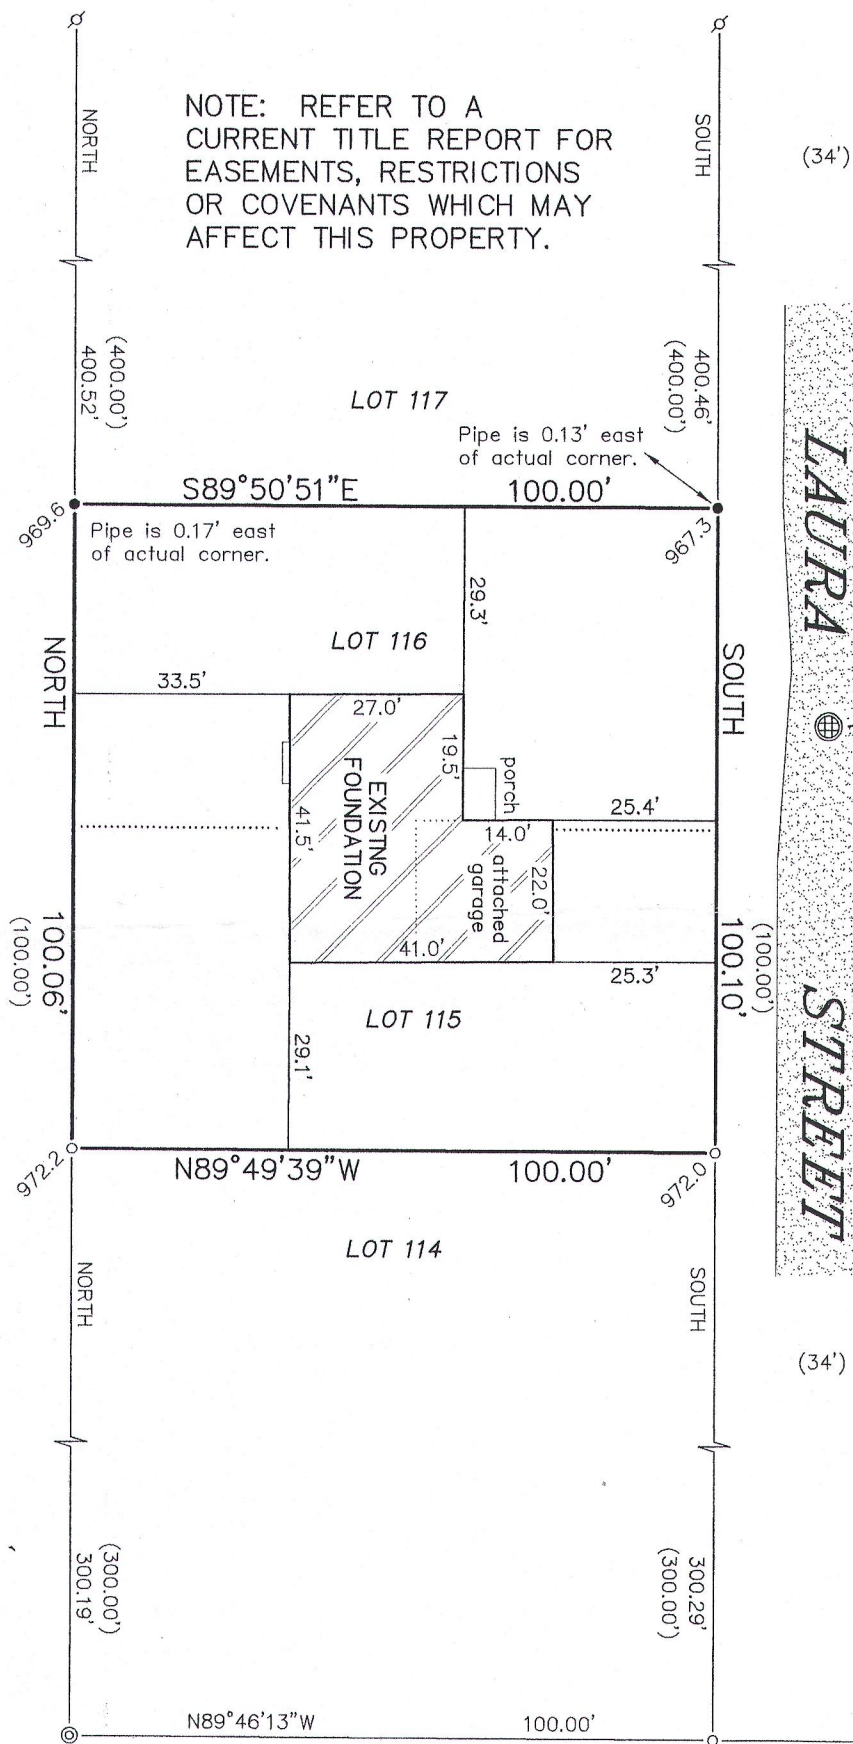


NOTE: ELEVATIONS ARE BASED OFF OF BENCHMARKS OBTAINED FROM THE DELAVAN LAKE SANITARY DISTRICT. SAID OFFICE HAD GIVEN AN ELEVATION OF 969.04' ON THE NORTH SIDE OF THE SANITARY SEWER MANHOLE RIM IN FRONT OF LOT 58 OF HILLSIDE SUBDIVISION, WHICH CHECKS OUT WITH THE ELEVATION OF 972.28' TAKEN ON THE SOUTHWEST CORNER ON THE TOP OF AN ELECTRIC TRANSFORMER, ALSO IN FRONT OF LOT 58 OF HILLSIDE SUBDIVISION.

LEGEND

- ⊙ FOUND 2-3/8" O.D. IRON PIPE
- FOUND 1-5/16" O.D. IRON PIPE
- FOUND 1-1/2" O.D. IRON PIPE
- ⌀ FOUND 3/4" DIAMETER IRON ROD
- 975.0 EXISTING ELEVATION
- () RECORDED AS

PROJECT BENCHMARK
SANITARY SEWER MANHOLE
INVERT ELEVATION = 963.85'
RIM ELEVATION = 968.51'

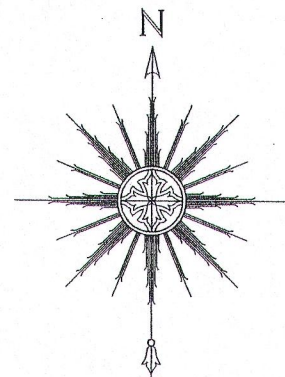

0 15' 30' 60'


SCALE: 1" = 30'

ADDITION NO. 1 TO ROBBINS SUBDIVISION


"I HEREBY CERTIFY THAT I HAVE SURVEYED THE ABOVE DESCRIBED PROPERTY AND THAT THE ABOVE MAP IS A CORRECT REPRESENTATION THEREOF AND SHOWS THE SIZE AND LOCATION OF THE PROPERTY, ITS EXTERIOR BOUNDARIES, THE LOCATION OF ALL VISIBLE STRUCTURES AND DIMENSIONS OF ALL PRINCIPAL BUILDINGS THEREON, BOUNDARY FENCES, APPARENT EASEMENTS, ROADWAYS AND ENCROACHMENTS, IF ANY."

"THIS SURVEY IS MADE FOR THE USE OF THE PRESENT OWNERS OF THE PROPERTY, AND THOSE WHO PURCHASE, MORTGAGE, OR GUARANTEE THE TITLE THERETO WITHIN ONE YEAR FROM DATE HEREOF."

SATTER SURVEYING, LLC
LAND SURVEYS, MAPPING AND PLANNING
272 ORIGIN STREET
BURLINGTON, WI 53105
262-661-4239

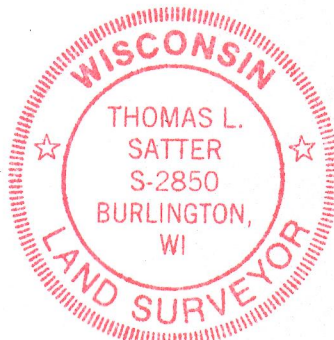

THIS IS NOT AN ORIGINAL PRINT
UNLESS THIS SEAL IS RED.

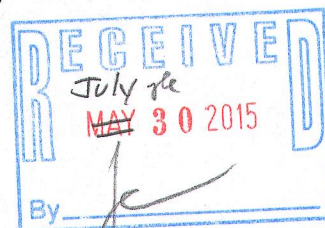

Thomas L. Satter
THOMAS L. SATTER S-2850

JULY 22, 2015
DATE

031508-AS BUILT
JOB NUMBER

EH-65

116-983