




SCALE 1"=30'

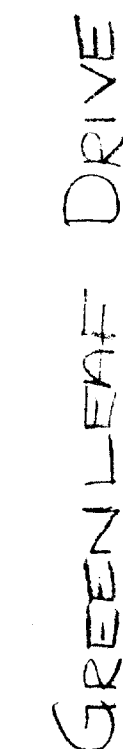

Lloyd L. Jensen
COUNTY SURVEYOR